



IMPORTANT NOTE

1. This plan was prepared for the sole purpose of the client for the specific purpose of recording the location of the water infrastructure on the plan. It is not to be used for any other purpose. The plan is prepared without the assumption of a duty of care to any other person (other than the Client). Third Party and may not be relied on by Third Party.
2. RPS Australia East Pty Ltd will not be liable (in negligence or otherwise) for any direct or indirect loss, damage, liability or claim arising out of or from this plan.
3. Where the plan is used for any other purpose, the user may not be copied, distributed, or reproduced by any process unless this note is clearly displayed on the plan.
4. Scale shown is correct for the original plan and any copies of this plan should be verified by checking against the original plan.
5. Spot values, hydrants and other visible surface indicators have been located by survey. Other information has been obtained from design and construction information provided by Third Parties and should be checked before use.

CERTIFICATION



RPS Australia East Pty Ltd (ACN 006 501 006) Registered Surveyor certifies that the locations of the water infrastructure on this plan have been surveyed in accordance with the Survey Act 1992 and the Survey Regulations 2009 and that the plan is a true and correct representation of the information provided to the client and that the plan is a true and correct representation of the information provided to the client and that the plan is a true and correct representation of the information provided to the client.

[Signature]
14/1/13
Authorized Signatory

LEGEND

- ① ISO 6 x 22.5° BEND
- ② ISO 6 x 45° BEND
- FH FIRE HYDRANT
- SV STOP VALVE
- ISO 6 PVC CLASS 12" U.N.O. PIPES
- APPROXIMATE LOCATION, WATER MAIN BURIED AT TIME OF SURVEY
- EXISTING MAIN
- W WATER TAG
- x PROPERTY WATER CONNECTION
- W WATER TAPPING BAND
- W WATER METER

 Scale 1:500 - Lengths are in Metres.

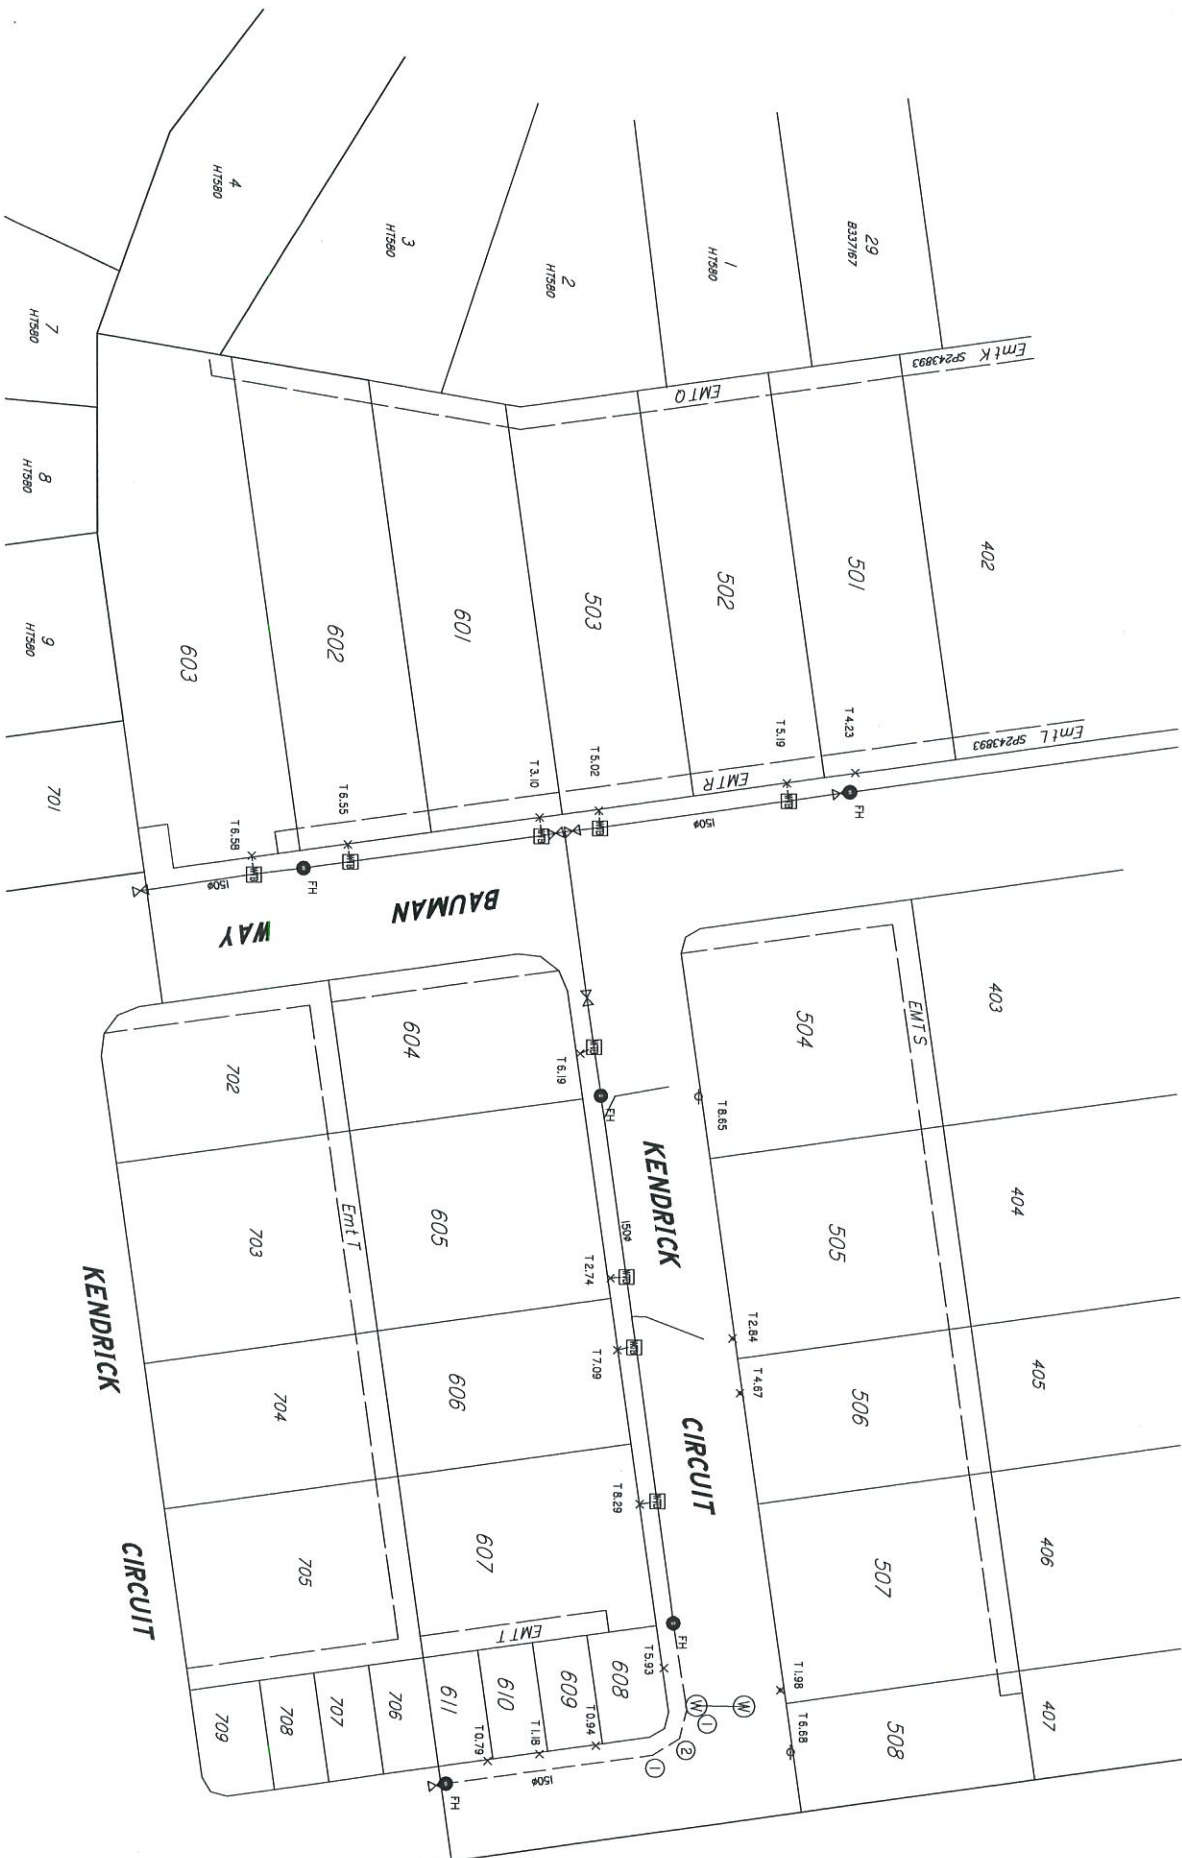

--	--	