




WORKS AS CONSTRUCTED

It is certified that the original drawings have been carefully compared with the works As Constructed as to line, level and dimensions and it has been accurately amended as required so as to constitute a true and correct record of the works As Constructed.

Signature: *[Signature]* Date: 13/6/14
 Name of Signatory: Jason Merlan
 RPEQ No.: 6336
 BRADFORD LEES PTY LTD

ISSUE	DATE	AUTHOR	COMMENTS	Works As Constructed	CLIENT	ASSOCIATE CONSULTANT	DATUM
A	27/02/14	AL	FINAL	Fyfe Pty Ltd (A.B.N. 57 006 116 130) hereby certifies that the Company has surveyed the position and level of the services shown on this plan and that the "as constructed" information is accurate.	J K CIVIL CONTRACTING PTY LTD	BRADLEES CIVIL CONSULTING	AHDD
				Authorised Delegate: <i>[Signature]</i> Date: 16/6/2014	FYFE PTY LTD 56 BUNGLE STREET ROHA QLD 4455 PO BOX 79 ROHA QLD 4455 TELEPHONE 61 7 4622 2777 FACSIMILE 61 7 4622 7766 info@fyfe.com.au www.fyfe.com.au	MARANOA REGIONAL COUNCIL	LEVEL ORIGIN PSM 181325 RL 321.423m
					CLEARVIEW RISE - STAGE 2 AS CONSTRUCTED CONTOURS		CONTOUR INTERVAL 0.2m
							FILE REFERENCE 37748-17-2
							DRAWN AL DATE 27/02/2014
							CHECKED MJS DATE 01/03/2014
							APPROVED JDM DATE / /2014
							PLAN NUMBER 37748_AS_CON_ST2
							SHEET OF ISSUE 1 1 A

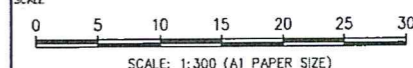

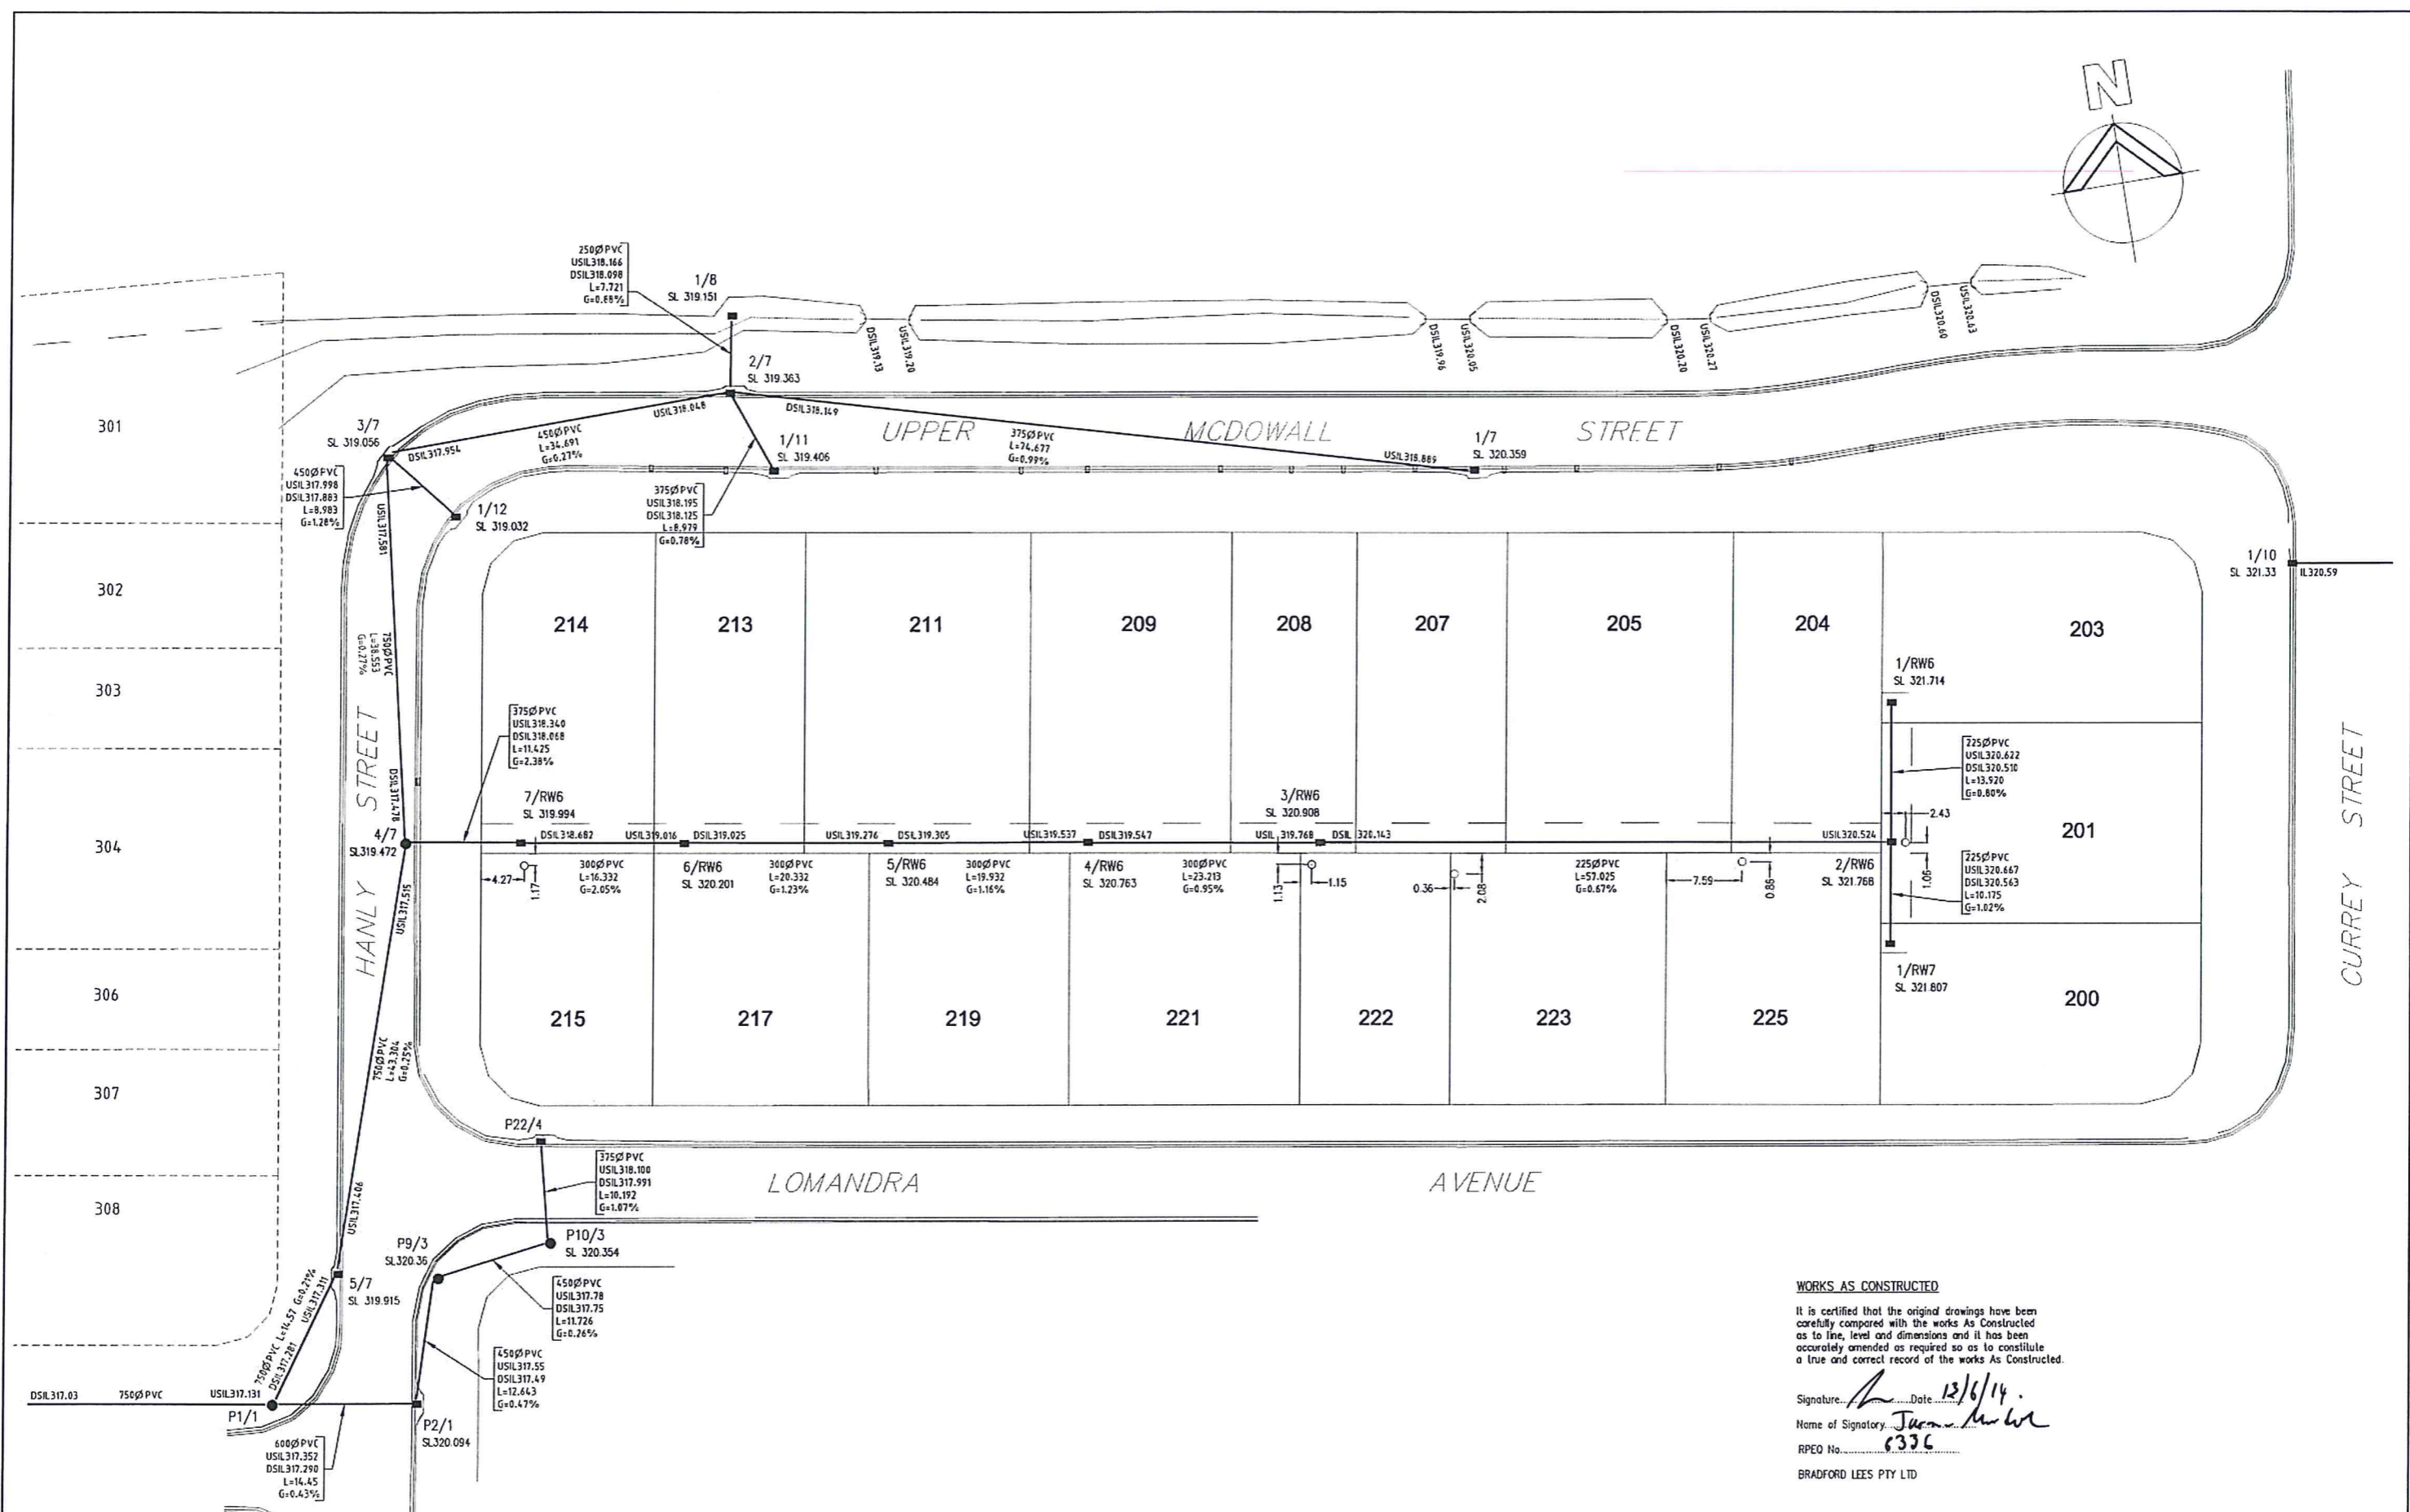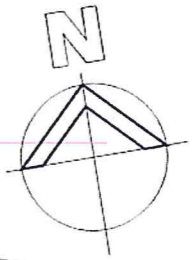

WORKS AS CONSTRUCTED

It is certified that the original drawings have been carefully compared with the works As Constructed as to line, level and dimensions and it has been accurately amended as required so as to constitute a true and correct record of the works As Constructed.

Signature: *[Signature]* Date: 12/6/14
 Name of Signatory: *[Signature]*
 RPEO No.: 6336
 BRADFORD LEES PTY LTD

ISSUE	DATE	AUTHOR	COMMENTS
A	27/02/14	AL	FINAL
B	03/06/14	AL	NEW SURVEY DATA ADDED

Works As Constructed

Fyfe Pty Ltd (A.B.N. 57 008 116 130) hereby certifies that the Company has surveyed the position and level of the services shown on this plan and that the "as constructed" information is accurate.

Authorised Delegate: *[Signature]*
 Date: 6/6/2014

FYFE PTY LTD
 56 BUNGLE STREET
 ROMA QLD 4455
 PO BOX 79
 ROMA QLD 4455
 TELEPHONE 61 7 4622 2777
 FACSIMILE 61 7 4622 7766
 info@fyfe.com.au
 www.fyfe.com.au

J K CIVIL CONTRACTING PTY LTD

**CLEARVIEW RISE - STAGE 2
 AS CONSTRUCTED
 STORMWATER & KERB**

BRADLEES CIVIL CONSULTING

MARANOA REGIONAL COUNCIL



SCALE: 1:300 (A1 PAPER SIZE)

DATE		AHDD	
LEVEL ORIGIN	PSM 181325 RL 321.423m	CONTOUR INTERVAL	-
FILE REFERENCE	37748-17-2	DRAWN	AL
CHECKED	MJS	DATE	27/02/2014
APPROVED	JDM	DATE	01/03/2014
PLAN NUMBER	37748_AS_SW_ST2_REV B	SHEET	1
		OF	1
		ISSUE	B

WORKS AS CONSTRUCTED

It is certified that the original drawings have been carefully compared with the works As Constructed as to line, level and dimensions and it has been accurately amended as required so as to constitute a true and correct record of the works As Constructed

Signature: *[Signature]* Date: 13/1/14
 Name of Signatory: Jason Marshall
 RPEQ No: CB31
 BRADFORD LEES PTY LTD

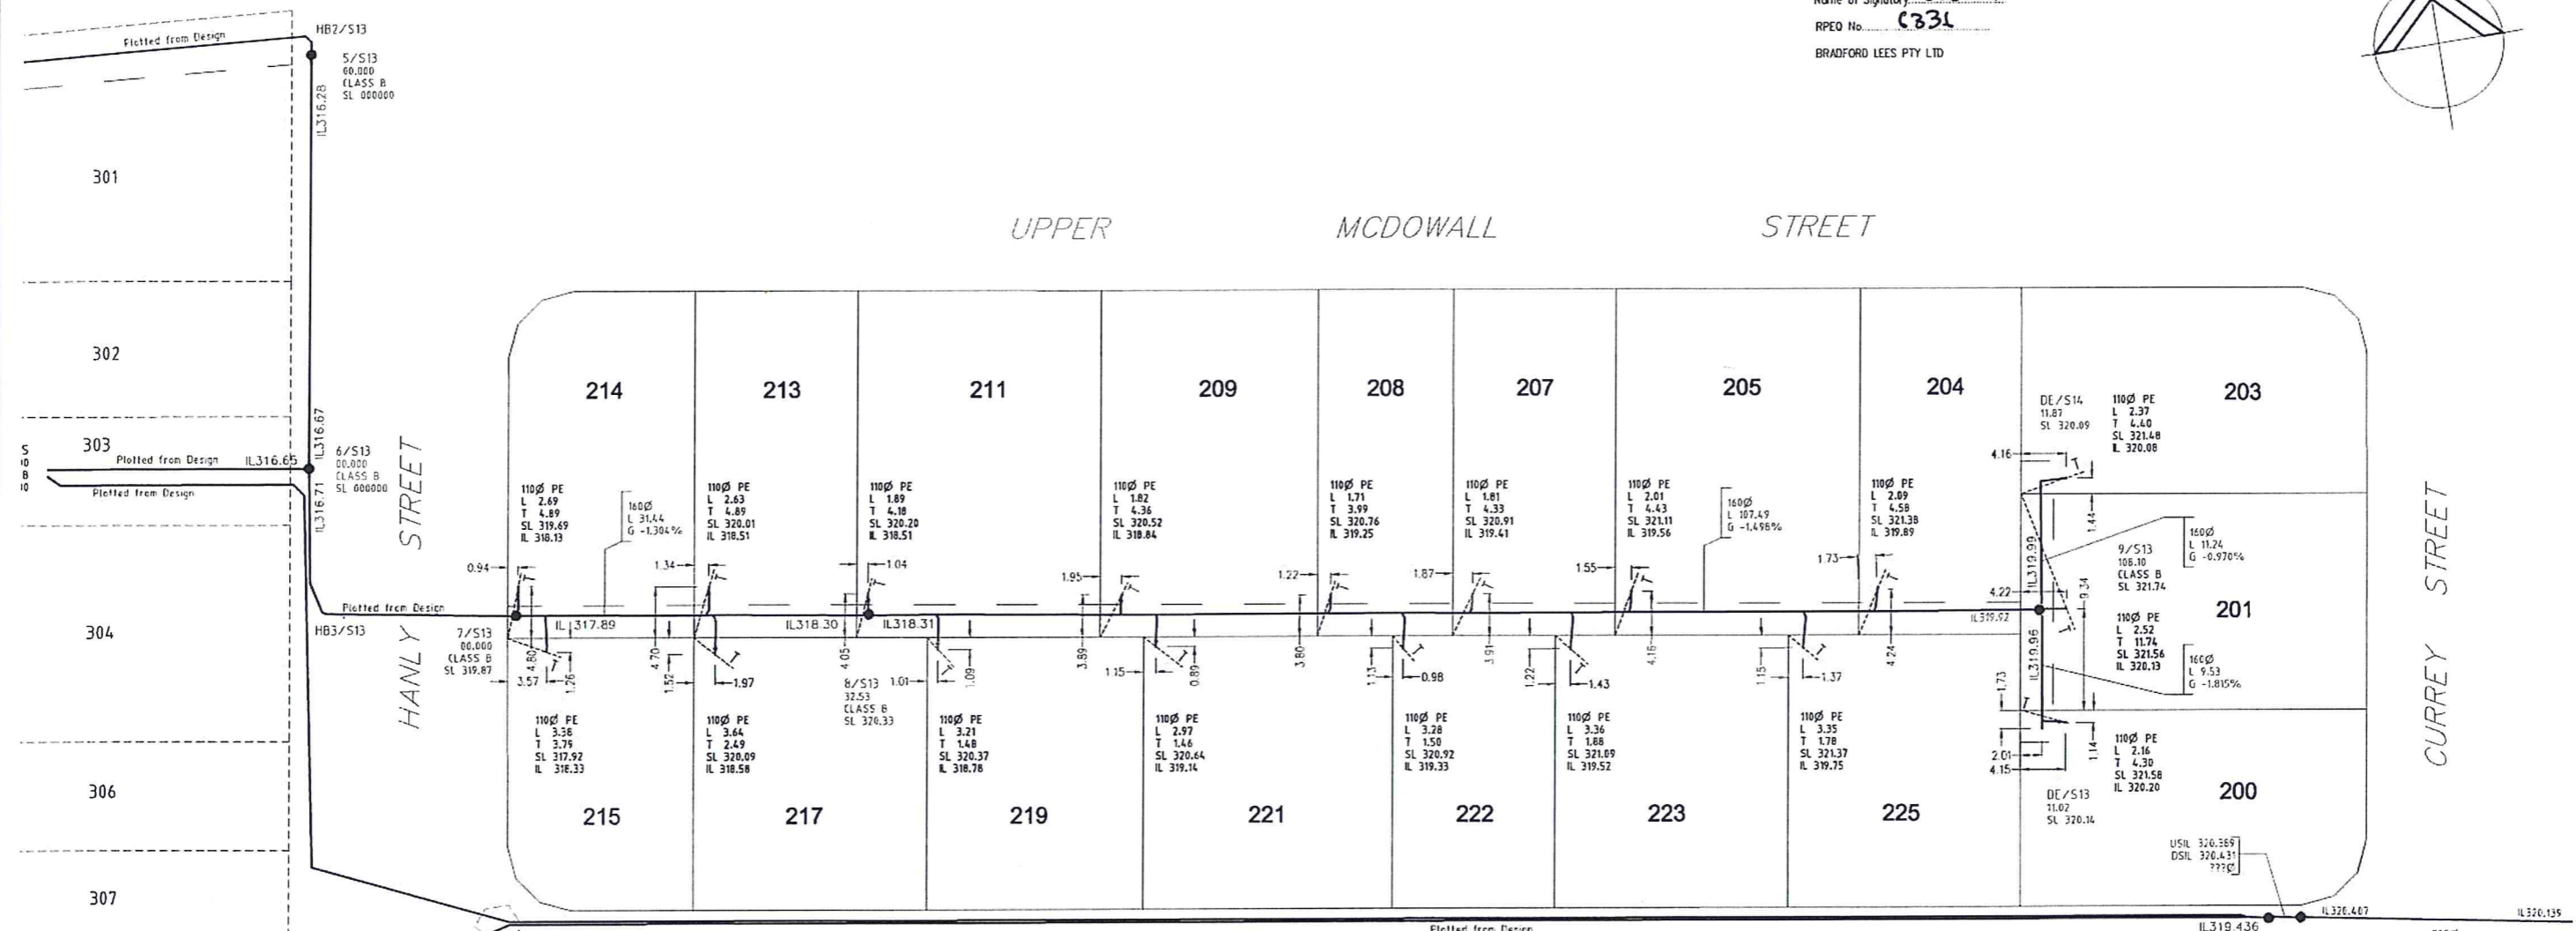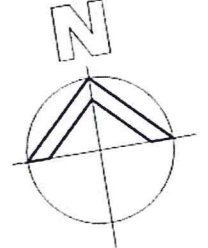

SEWER LINE BACKFILLED BEFORE ASCON SURVEY, NO CONDUIT PLACED AT SEWER INTERSECTION.

SEWER LINE IN CLOUDED AREA WAS BACKFILLED BEFORE ASCON SURVEY. CONDUITS PLACED ON SEWER LINE HAVE BEEN BLOCKED WITH SOIL. HEIGHTS CAN'T BE SURVEYED, ONLY POSITION.

ISSUE	DATE	AUTHOR	COMMENTS
A	27/02/14	AL	FINAL
B	03/06/14	AL	REVISED SURVEY DATA ADDED

Works As Constructed
 Fyfe Pty Ltd (A.B.N. 57 008 116 130) hereby certifies that the Company has surveyed the position and level of the services shown on this plan and that the "as constructed" information is accurate.
 Authorised Delegates: *[Signature]*
 Date: 16/06/2014

FYFE PTY LTD
 56 BUNGL STREET
 ROMA QLD 4455
 PO BOX 79
 ROMA QLD 4455
 TELEPHONE 61 7 4622 2777
 FACSIMILE 61 7 4622 7166
 info@fyfe.com.au
 www.fyfe.com.au

J K CIVIL CONTRACTING PTY LTD
 PROJECT: CLEARVIEW RISE - STAGE 2 AS CONSTRUCTED SEWERAGE

ASSOCIATE CONSULTANT: BRADLEES CIVIL CONSULTING
 LOCAL GOVERNMENT: MARANOVA REGIONAL COUNCIL
 SCALE: 0 5 10 15 20 25 30
 SCALE: 1:300 (A1 PAPER SIZE)

DATUM		AHDD	
LEVEL ORIGIN	PSM 181325 RL 321.423m		
CONTOUR INTERVAL			
FILE REFERENCE	37748-17-2		
DRAWN	AL	DATE	27/02/2014
CHECKED	MJS	DATE	01/03/2014
APPROVED	JDM	DATE	/ / 2014
PLAN NUMBER	37748_AS_SEW_ST2_REVB	SHEET	OF



WORKS AS CONSTRUCTED

It is certified that the original drawings have been carefully compared with the works As Constructed as to line, level and dimensions and it has been accurately amended as required so as to constitute a true and correct record of the works As Constructed.

Signature: *[Signature]* Date: 13/6/14
 Name of Signatory: *Jason Murdoch*
 RPEO No: 6336
 BRADFORD LEES PTY LTD

LEGEND

- c — GAS
- — WATER BORE
- w — WATER
- FH ● FIRE HYDRANT
- WM ■ WATER METER
- SV ◀ WATER VALVE
- TAP ◀ WATER TAP
- GV ◀ GAS VALVE
- IO ● GAS I/O
- EP ● GAS TEST POINT

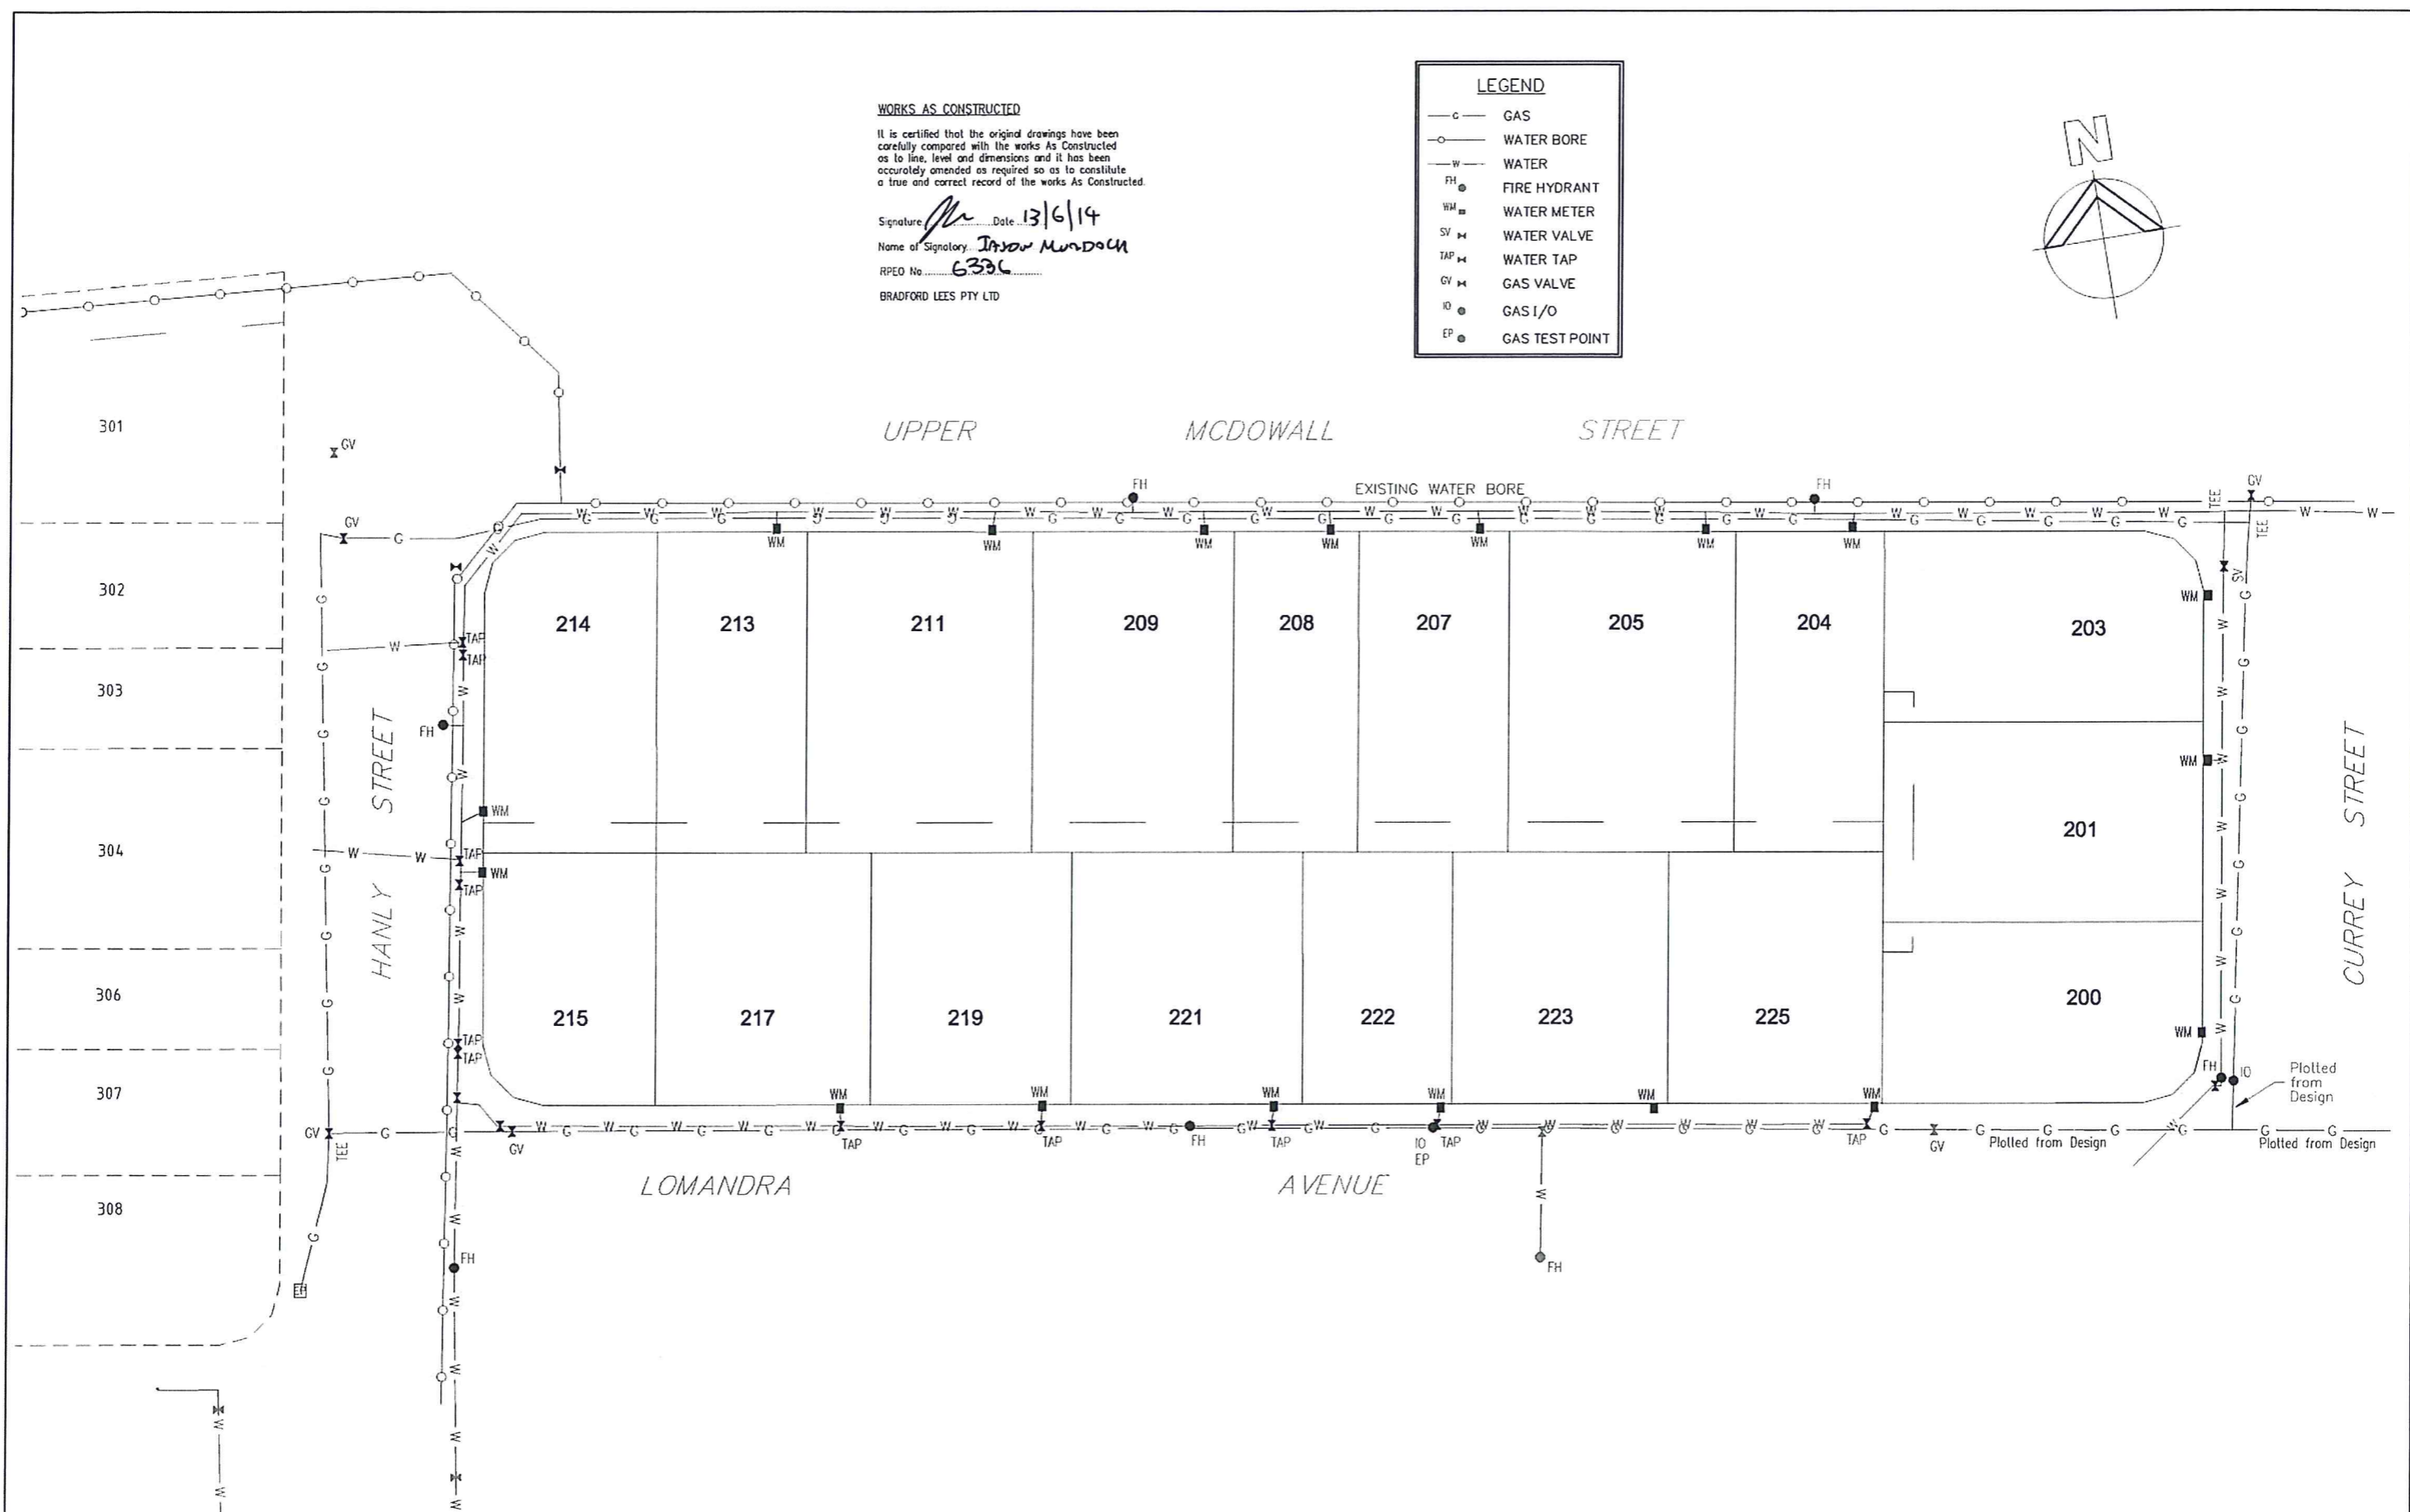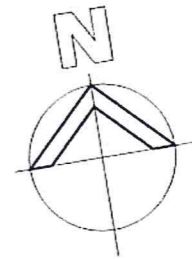


ISSUE	DATE	AUTHOR	COMMENTS
A	27/02/14	AL	FINAL
B	03/05/14	AL	NEW SURVEY INFO ADDED

Works As Constructed
 Fyfe Pty Ltd (A.B.N. 57 008 116 130) hereby certifies that the Company has surveyed the position and level of the services shown on this plan and that the "as constructed" information is accurate.
 Authorised Delegate: *[Signature]*
 Date: 16/04/2014

FYFE PTY LTD
 56 BUNGLE STREET
 RDHA QLD 4455
 PO BOX 79
 RDHA QLD 4455
 TELEPHONE 61 7 4622 2777
 FACSIMILE 61 7 4622 7766
 info@fyfe.com.au
 www.fyfe.com.au

J K CIVIL CONTRACTING PTY LTD
 PROJECT: **CLEARVIEW RISE - STAGE 2 AS CONSTRUCTED GAS & WATER**

ASSOCIATE CONSULTANT: **BRADLEES CIVIL CONSULTING**
 LOCAL GOVERNMENT: **MARANOA REGIONAL COUNCIL**

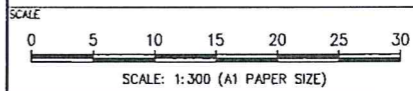

DATUM	AHDD
LEVEL ORIGIN	PSM 181325 RL 321.423m
CONTOUR INTERVAL	-
FILE REFERENCE	37748-17-2
DRAWN	AL
DATE	27/02/2014
CHECKED	MJS
DATE	01/03/2014
APPROVED	JDM
DATE	/ / 2014
PLAN NUMBER	37748_AS_WTR_ST2_REVB
SHEET OF	1 1
ISSUE	B

Plotted from Design

Plotted from Design

Plotted from Design