


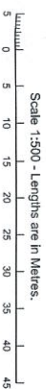

- ## CERTIFICATION

Authorized Signatory \_\_\_\_\_ Date 11/14/13

[illegible]