

WORKS AS CONSTRUCTED
 It is certified that the original drawings have been carefully compared with the works As Constructed as to line, level and dimensions and it has been accurately amended as required so as to constitute a true and correct record of the works As Constructed.

Signature: *[Signature]* Date: 13/7/15
 Name of Signatory: *[Signature]* M. J.
 RPEO No: 6376
 BRADFORD LEES PTY LTD

ISSUE	DATE	AUTHOR	COMMENTS
A	24/11/2014	AZL	FINAL

Works As Constructed
 Fyfe Pty Ltd (A.B.N. 57 008 116 130) hereby certifies that the Company has surveyed the position and level of the services shown on this plan and that the "as constructed" information is accurate.

[Signature]
 Surveyor
 Date: 4/05/2015

FYFE PTY LTD
 56 BUNGLE STREET
 ROHA QLD 4455
 PO BOX 79
 ROHA QLD 4455
 TELEPHONE 61 7 4622 2777
 FACSIMILE 61 7 4622 7766
 info@fyfe.com.au
 www.fyfe.com.au

CLIENT
J K CIVIL CONTRACTING PTY LTD



PROJECT
**CLEARVIEW RISE - STAGE 3
 AS CONSTRUCTED CONTOURS**

ASSOCIATE CONSULTANT
BRADLEES CIVIL CONSULTING



LOCAL GOVERNMENT
MARANOA REGIONAL COUNCIL

SCALE
 0 10 20 30 40
 SCALE: 1:400 (A1 PAPER SIZE)

DATUM		AHDD	
LEVEL ORIGIN	PSM 181325 RL 321.423m		
CONTOUR INTERVAL	0.2m		
FILE REFERENCE	37748-15-14		
DRAWN	AL	DATE	24/11/2014
CHECKED	MJS	DATE	01/05/2015
APPROVED	JDM	DATE	04/05/2015
PLAN NUMBER	37748_AS_CON_ST3_A	SHEET OF	ISSUE

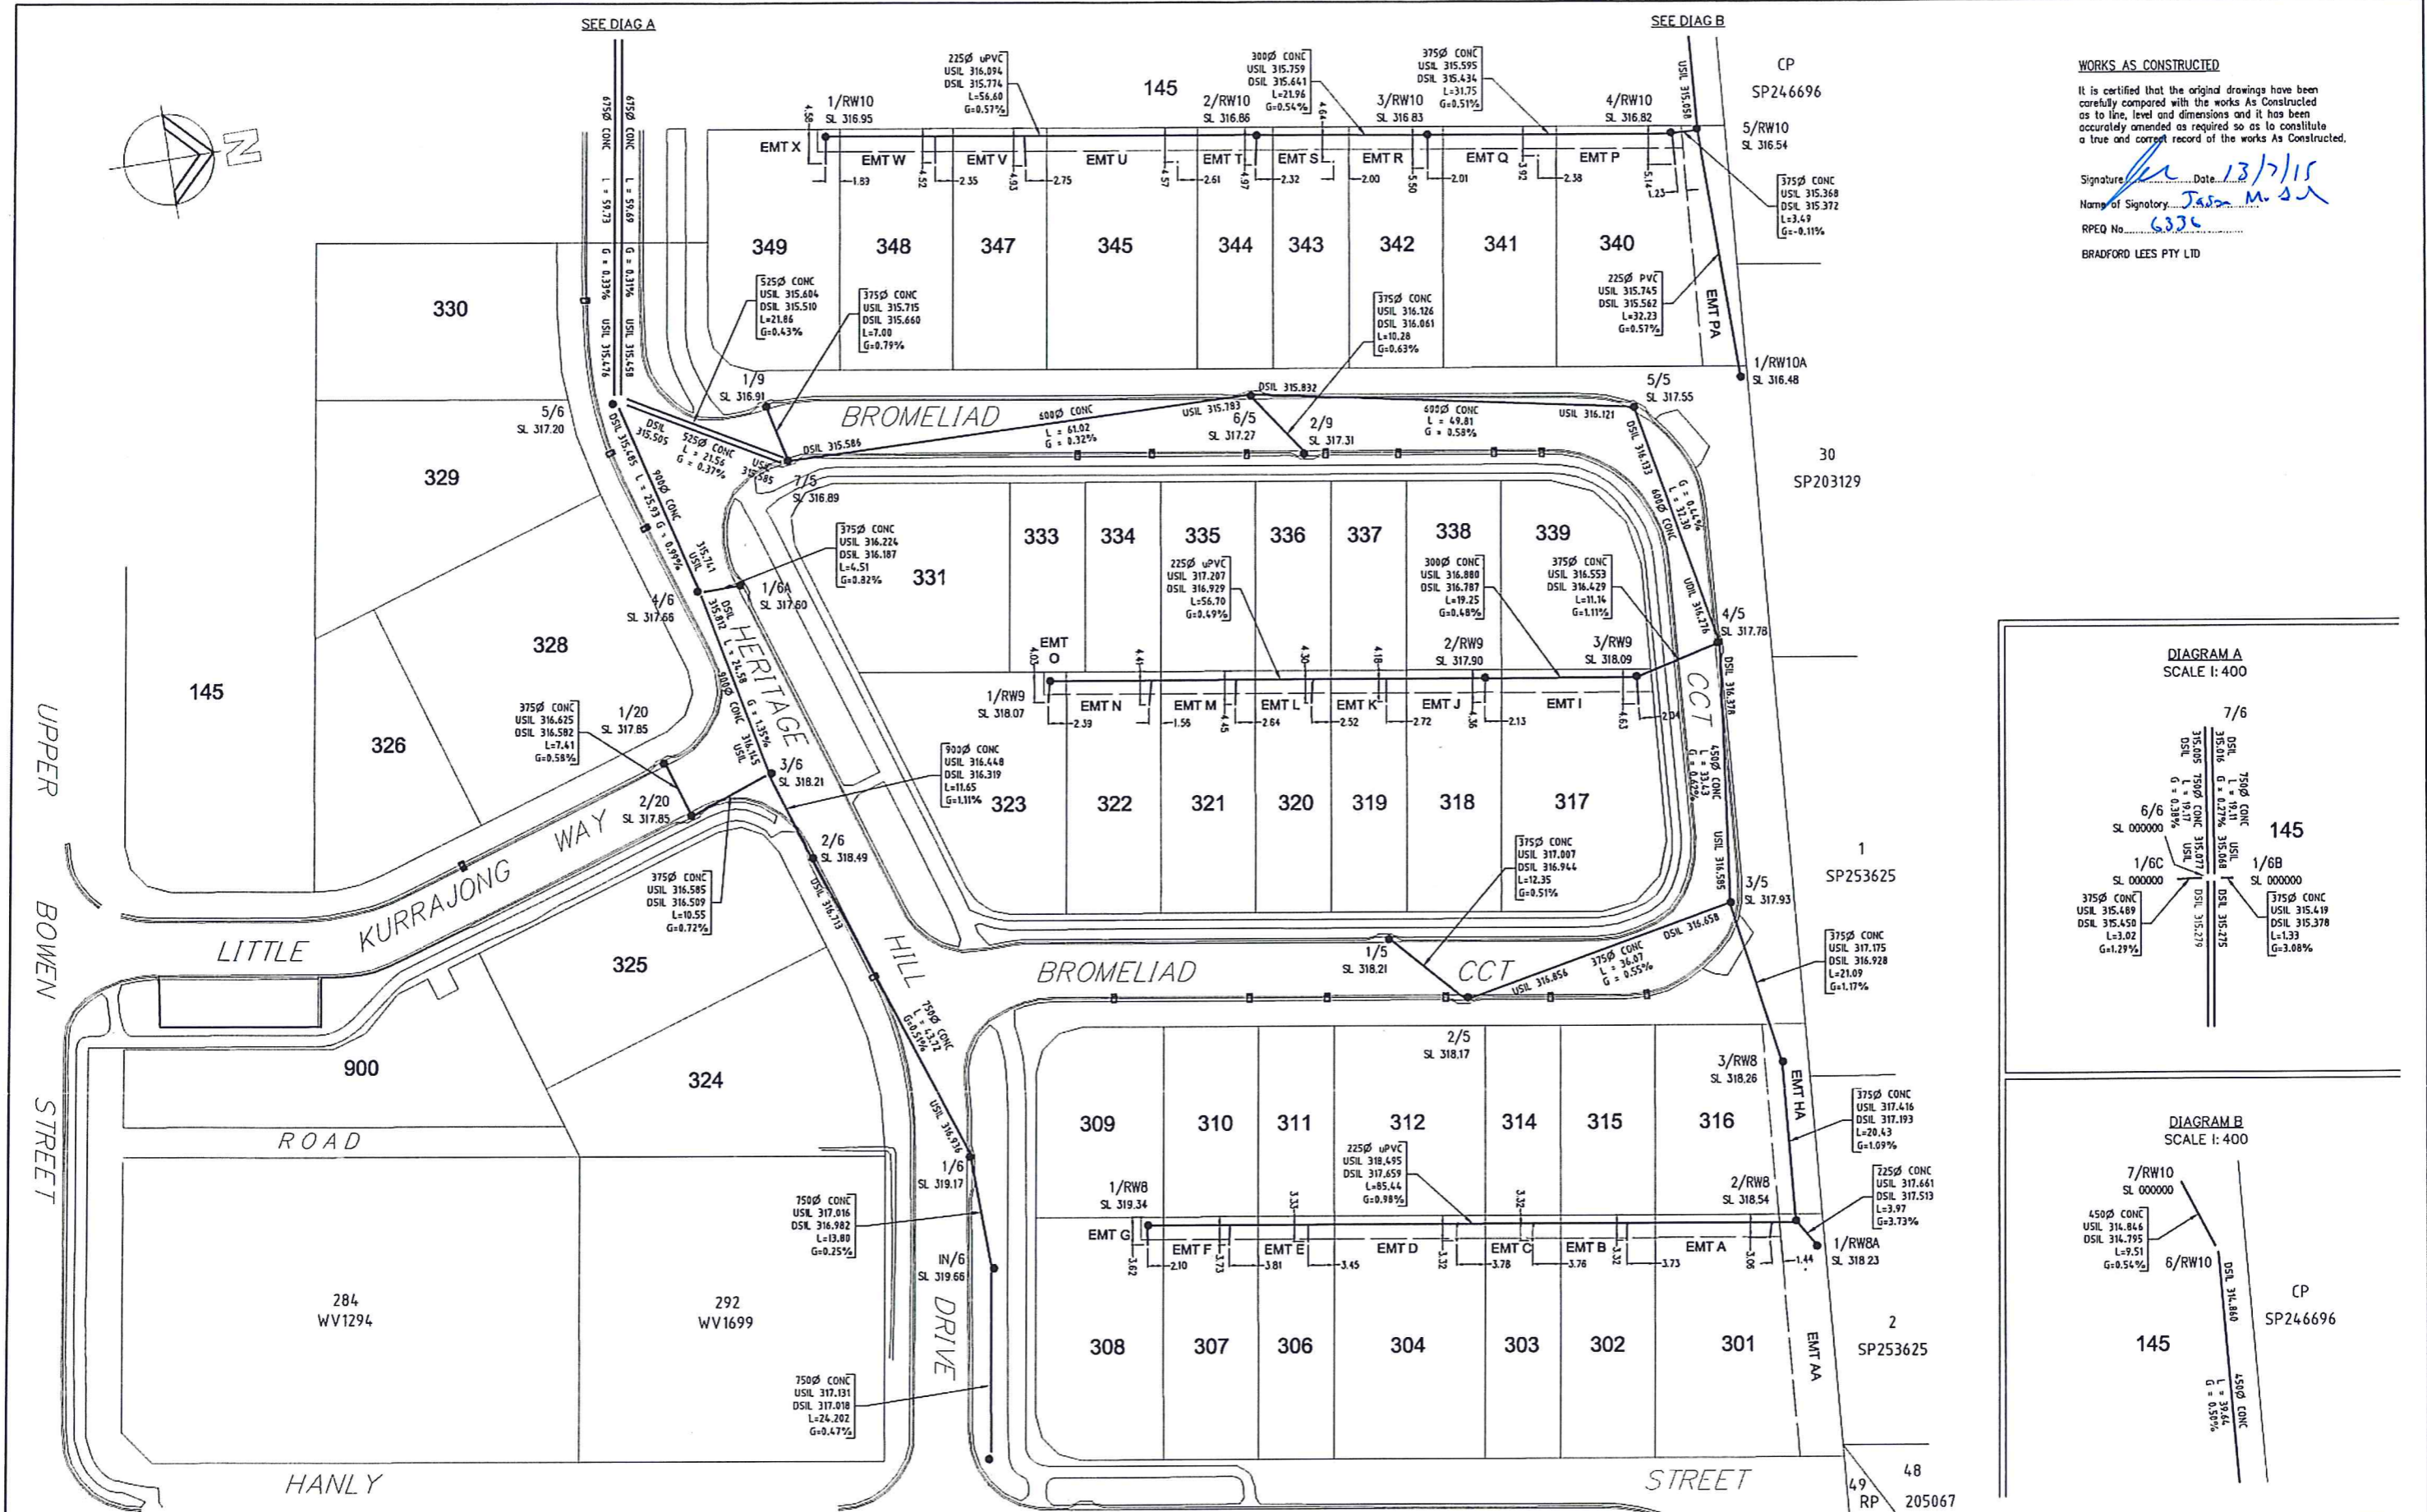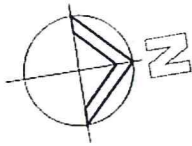

WORKS AS CONSTRUCTED
 It is certified that the original drawings have been carefully compared with the works As Constructed as to line, level and dimensions and it has been accurately amended as required so as to constitute a true and correct record of the works As Constructed.
 Signature: *[Signature]* Date: 13/1/15
 Name of Signatory: Jason M. Sullivan
 RPED No: 6332
 BRADFORD LEES PTY LTD

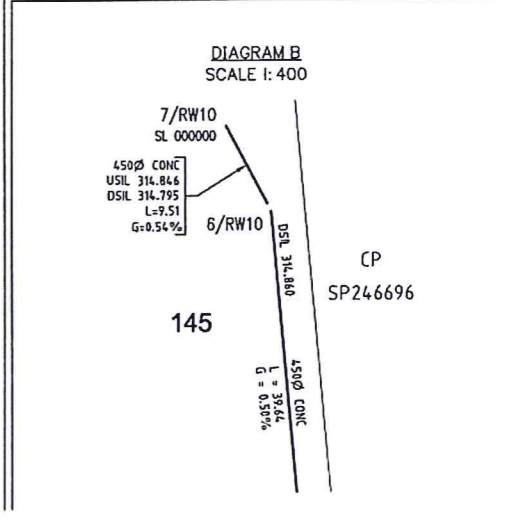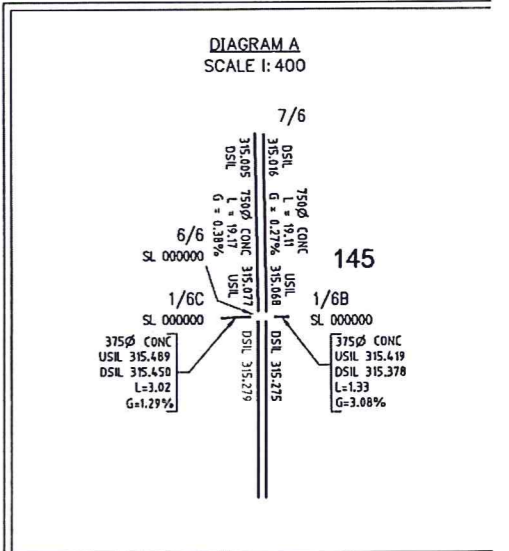

ISSUE	DATE	AUTHOR	COMMENTS
A	10/04/2015	AZL	FINAL




Works As Constructed
 Fyfe Pty Ltd (A.B.N. 57 008 116 130) hereby certifies that the Company has surveyed the position and level of the services shown on this plan and that the "as constructed" information is accurate.
 Surveyor: *[Signature]*
 Date: 10/5/2015

FYFE PTY LTD
 56 BUNGLE STREET
 ROMA QLD 4455
 PO BOX 79
 ROMA QLD 4455
 TELEPHONE 61 7 4622 2777
 FACSIMILE 61 7 4622 7766
 info@fyfe.com.au
 www.fyfe.com.au

J K CIVIL CONTRACTING PTY LTD
 PROJECT: CLEARVIEW RISE - STAGE 3
 AS CONSTRUCTED STORMWATER & KERB

ASSOCIATE CONSULTANT
BRADLEES CIVIL CONSULTING
 LOCAL GOVERNMENT
MARANOVA REGIONAL COUNCIL
 SCALE: 0 10 20 30 40
 SCALE: 1:400 (A1 PAPER SIZE)

DATUM		AHDD	
LEVEL ORIGIN	PSM 181325 RL 321.423m	FILE REFERENCE	37748-24-1
CONTOUR INTERVAL	-	DRAWN	AZL
		CHECKED	MJS
		APPROVED	JDM
		DATE	10/04/2015
		DATE	01/05/2015
		DATE	04/05/2015
PLAN NUMBER	37748_AS_SWT_ST3_A	SHEET OF	1 1
		ISSUE	A

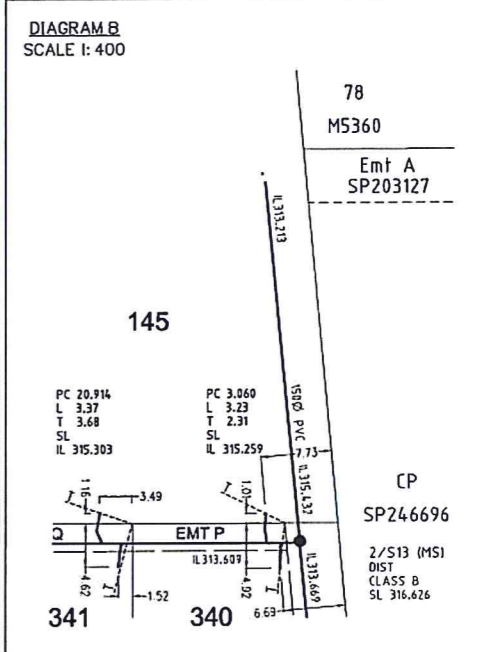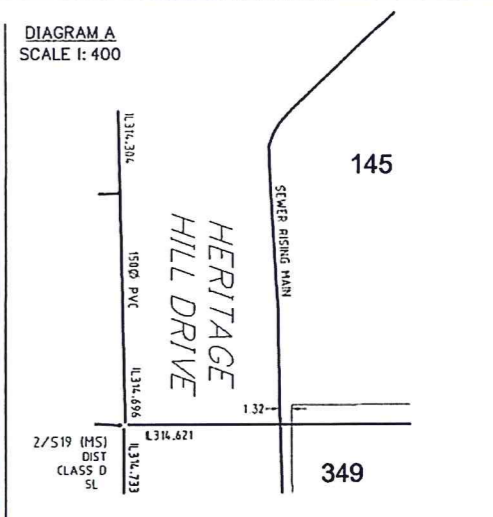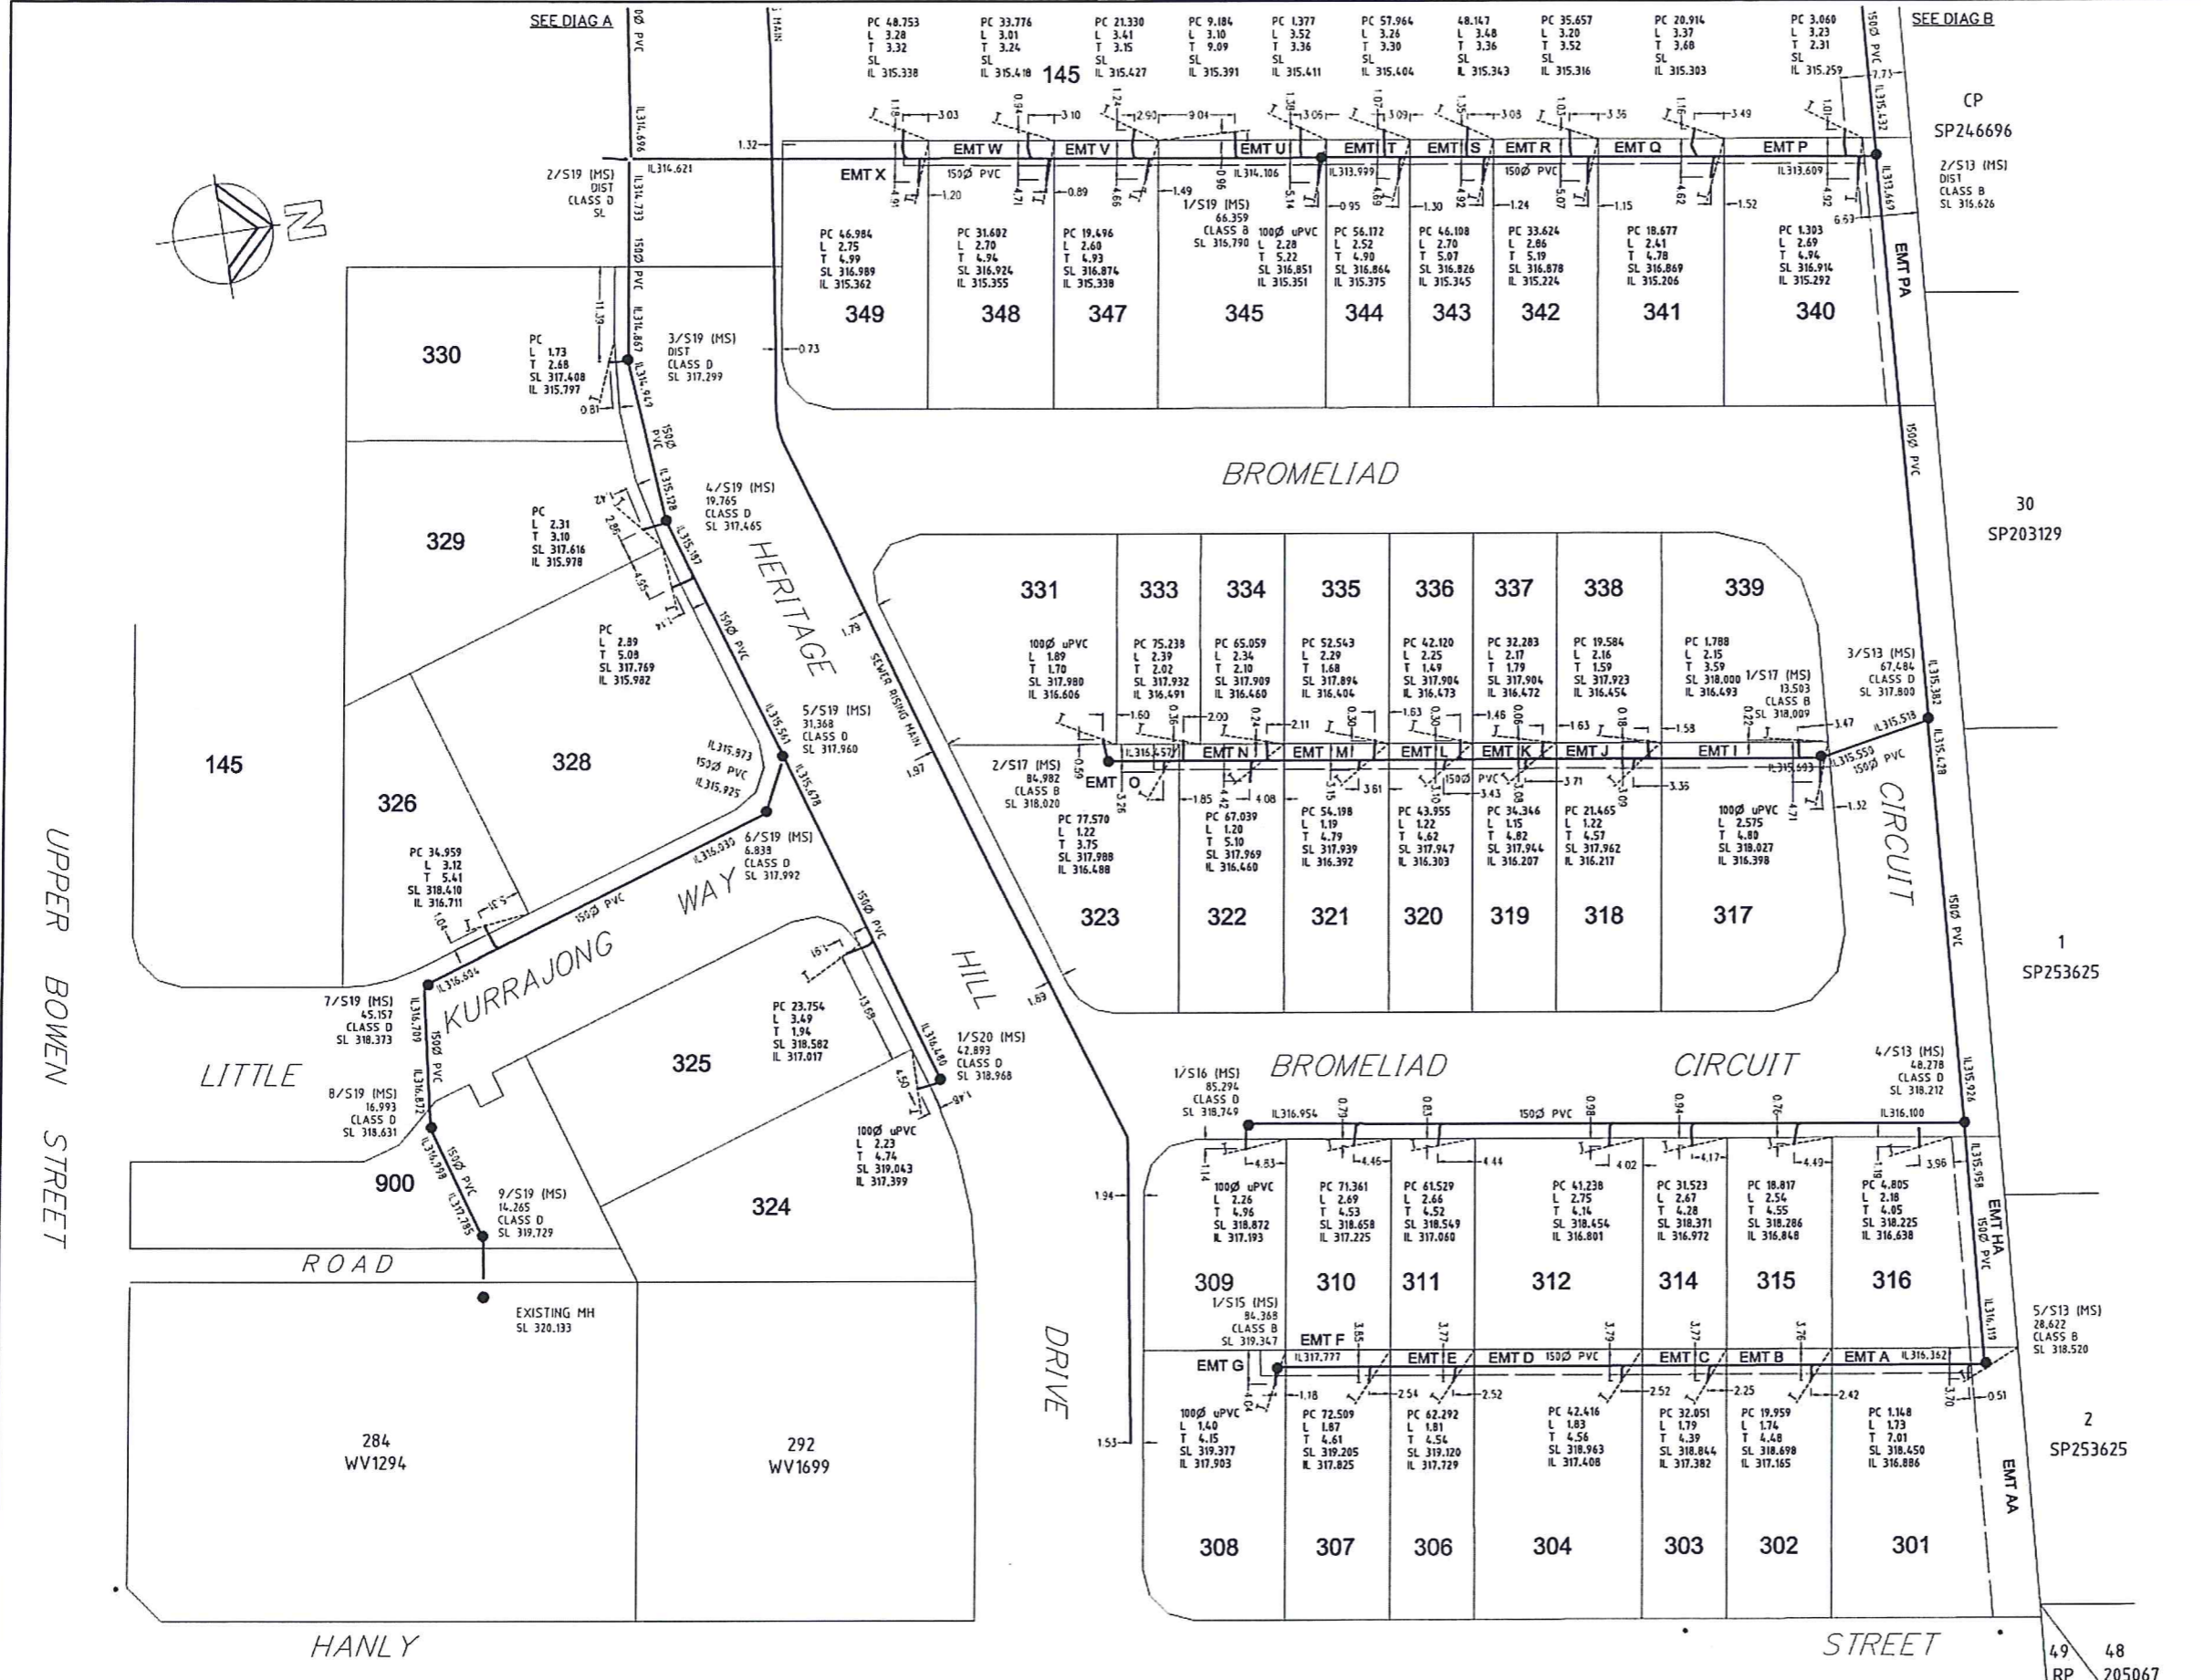

WORKS AS CONSTRUCTED

It is certified that the original drawings have been carefully compared with the works As Constructed as to line, level and dimensions and it has been accurately amended as required so as to constitute a true and correct record of the works As Constructed.

Signature: *[Signature]* Date: 12/7/15
 Name of Signatory: *Jason Munn*
 RPEQ No.: *3336*
 BRADFORD LEES PTY LTD

ISSUE	DATE	AUTHOR	COMMENTS
A	10/04/2015	AZL	FINAL

Works As Constructed

Fyfe Pty Ltd (A.B.N. 57 008 116 130) hereby certifies that the Company has surveyed the position and level of the services shown on this plan and that the "as constructed" information is accurate.

Authorised Delegate: *[Signature]*
 Date: *14/05/2015*

FYFE PTY LTD
 56 BUNGL STREET
 ROMA QLD 4455
 PO BOX 79
 ROMA QLD 4455
 TELEPHONE 61 7 4622 2777
 FACSIMILE 61 7 4622 7766
 info@fyfe.com.au
 www.fyfe.com.au


J K CIVIL CONTRACTING PTY LTD



**CLEARVIEW RISE - STAGE 3
 AS CONSTRUCTED SEWERAGE**

BRADLEES CIVIL CONSULTING

MARANOA REGIONAL COUNCIL

DATUM	AHDD
LEVEL ORIGIN	PSM 181325 RL 321.423m
CONTOUR INTERVAL	-
FILE REFERENCE	37748-15-14
DRAWN	AZL
CHECKED	MJS
APPROVED	JDM
PLAN NUMBER	37748_AS_SEW_ST3_A
SHEET OF	1 1 A

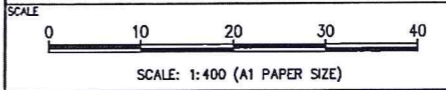

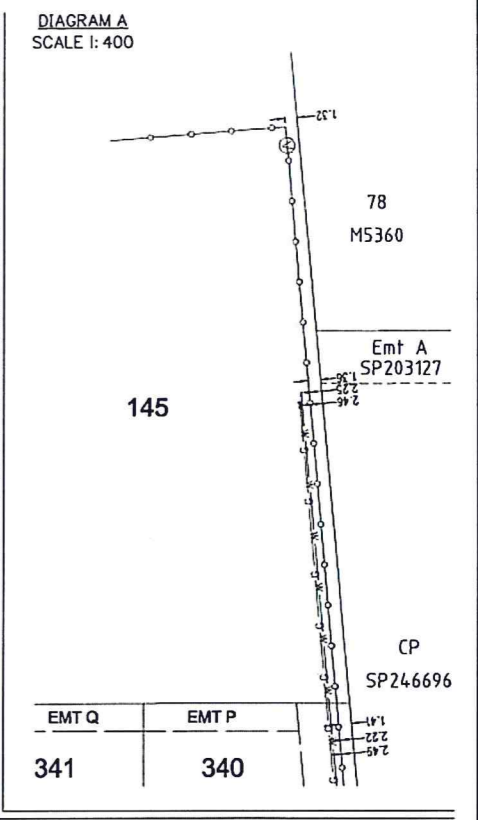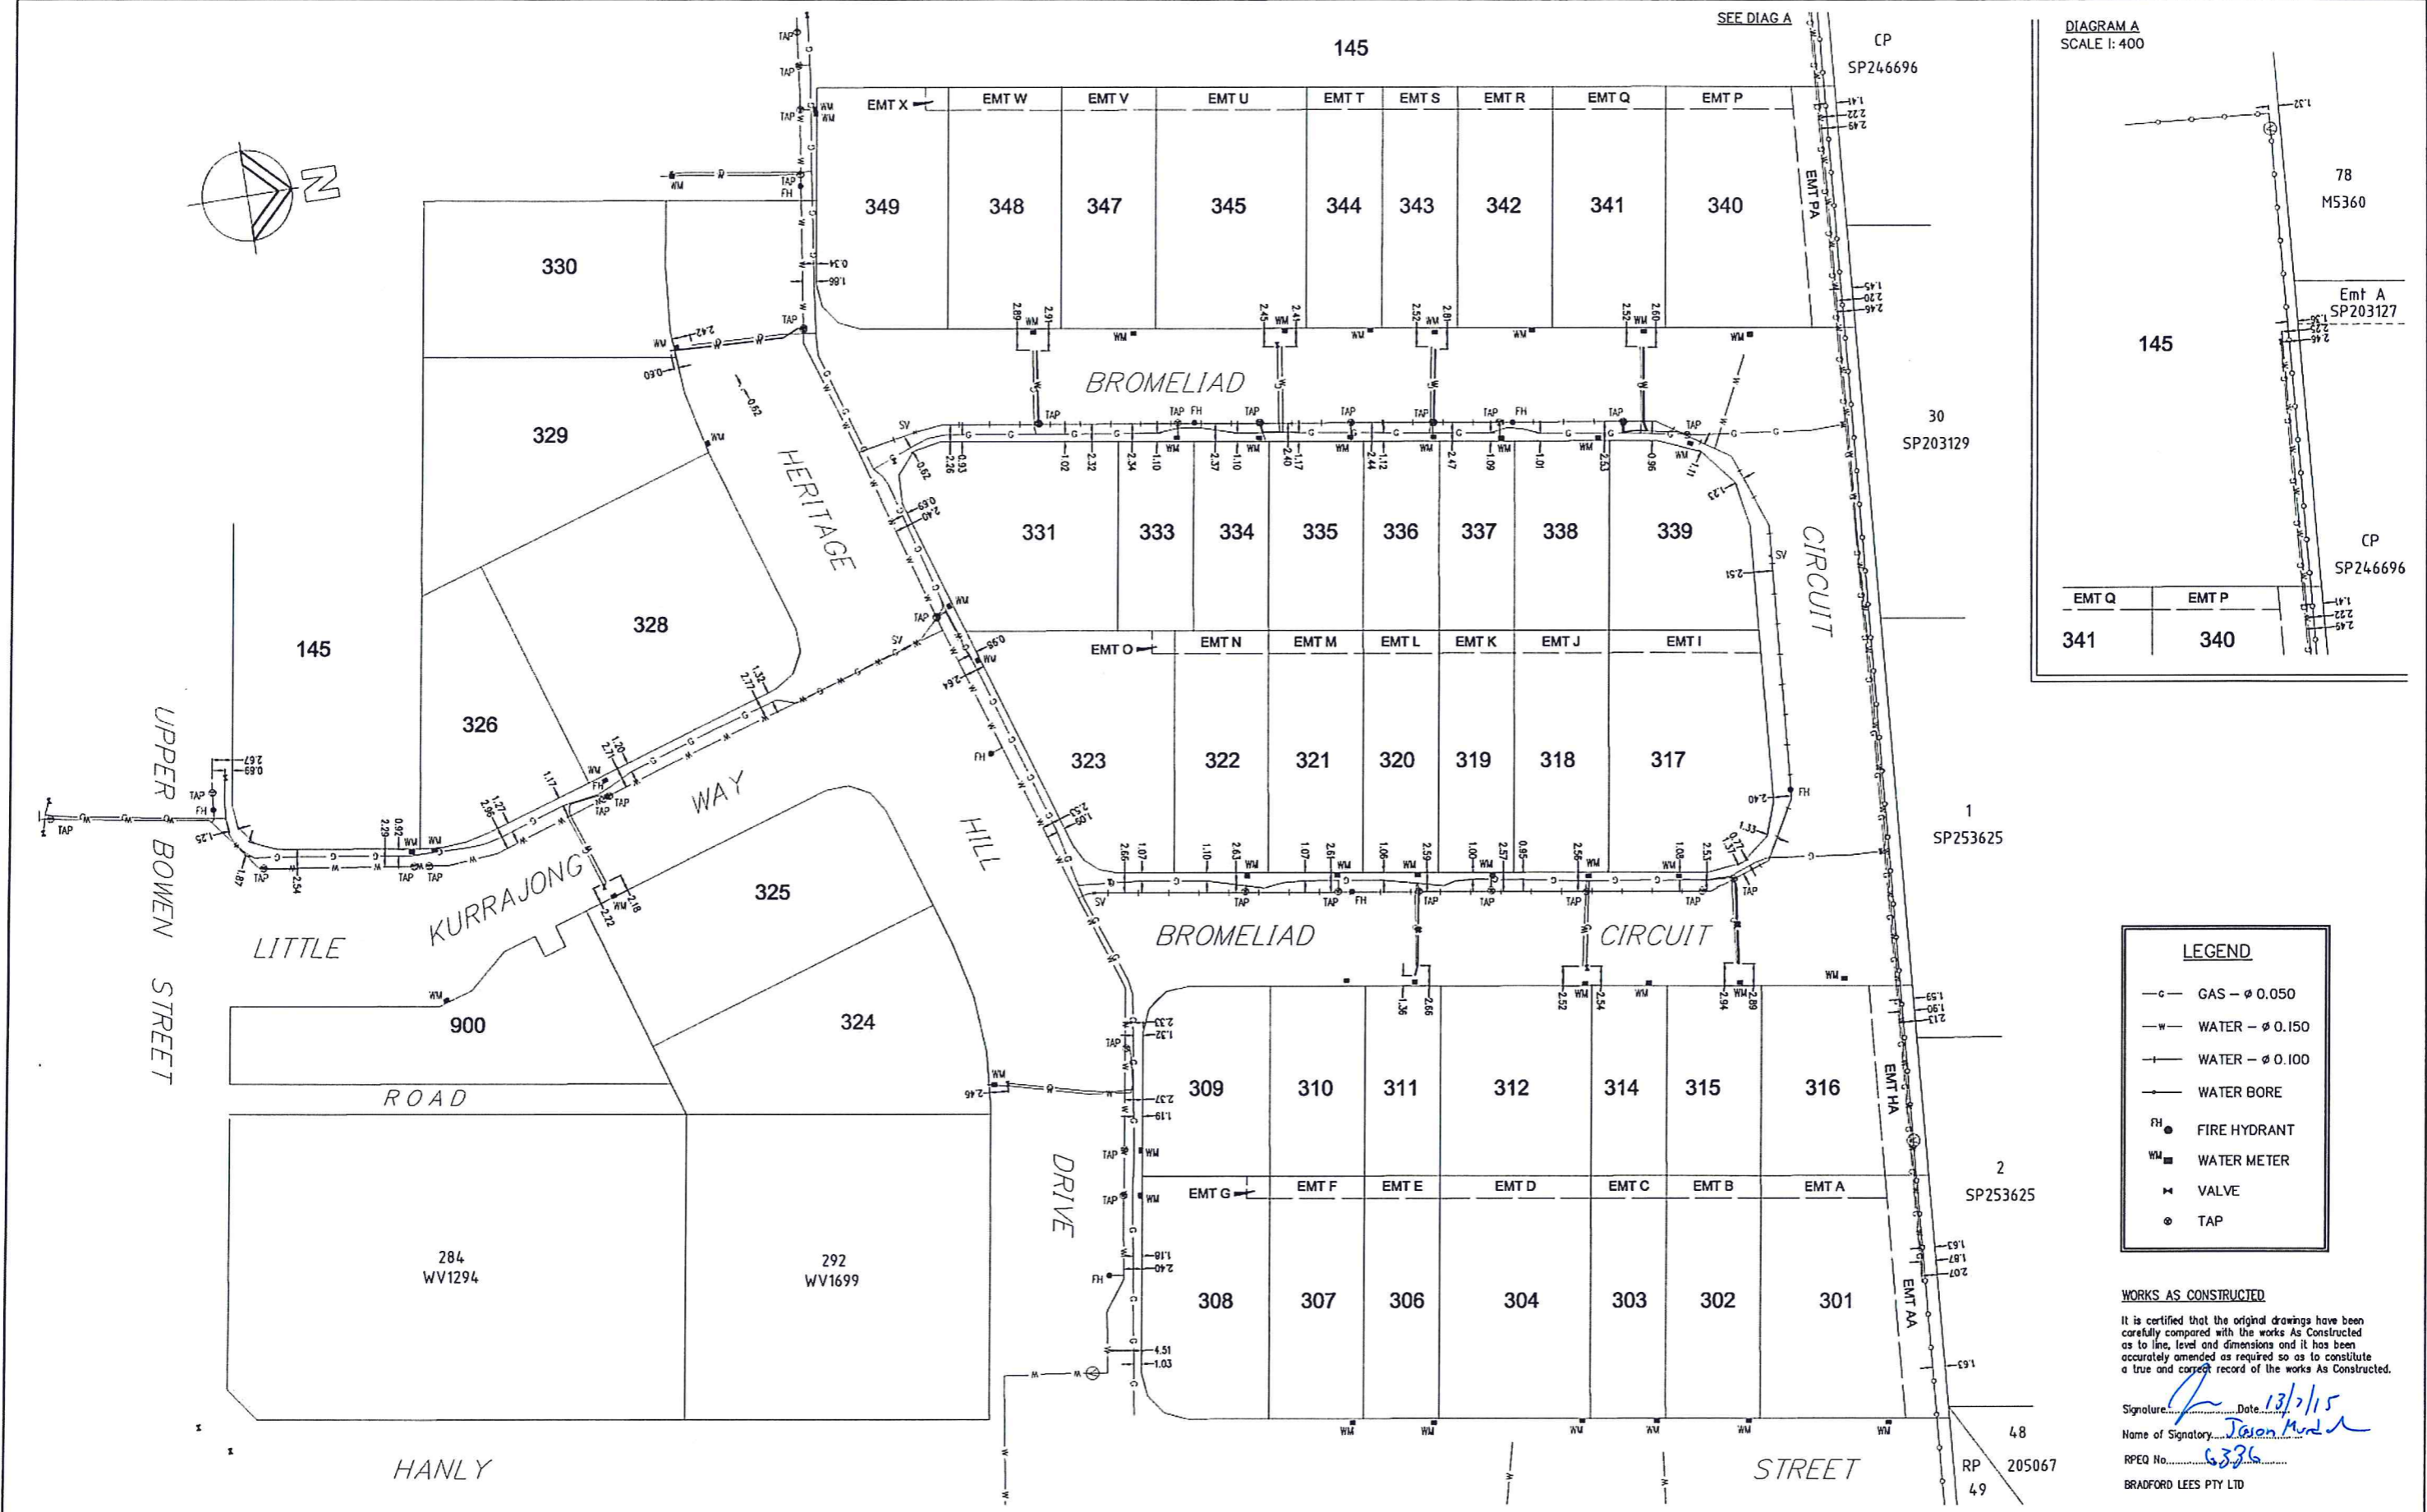

LEGEND

- c- GAS - ϕ 0.050
- w- WATER - ϕ 0.150
- w- WATER - ϕ 0.100
- - WATER BORE
- FH FIRE HYDRANT
- WM WATER METER
- VALVE
- TAP

WORKS AS CONSTRUCTED

It is certified that the original drawings have been carefully compared with the works As Constructed as to line, level and dimensions and it has been accurately amended as required so as to constitute a true and correct record of the works As Constructed.

Signature: *[Signature]* Date: 13/11/15
 Name of Signatory: Jason Munn
 RPEQ No. 6336
 BRADFORD LEES PTY LTD

ISSUE	DATE	AUTHOR	COMMENTS
A	10/04/2015	AZL	FINAL

Works As Constructed

Fyfe Pty Ltd (A.B.N. 57 008 116 130) hereby certifies that the Company has surveyed the position and level of the services shown on this plan and that the "as constructed" information is accurate.

Surveyor: *[Signature]*
 Date: 10/05/2015

FYFE PTY LTD
 56 BUNGL STREET
 ROMA QLD 4455
 PO BOX 79
 ROMA QLD 4455
 TELEPHONE 61 7 4622 2777
 FACSIMILE 61 7 4622 7766
 info@fyfe.com.au
 www.fyfe.com.au

J K CIVIL CONTRACTING PTY LTD

**CLEARVIEW RISE - STAGE 3
 AS CONSTRUCTED GAS & WATER**

BRADLEES CIVIL CONSULTING

MARANOA REGIONAL COUNCIL

SCALE: 0 10 20 30 40
 SCALE: 1:400 (A1 PAPER SIZE)

DATUM	AHDD
LEVEL ORIGIN	PSM 181325 RL 321.423m
CONTOUR INTERVAL	-
FILE REFERENCE	37748-24-1
DRAWN	AZL
DATE	10/04/2015
CHECKED	MJS
DATE	01/05/2015
APPROVED	JDM
DATE	04/05/2015
PLAN NUMBER	37748_AS_WTR_ST3_A
SHEET OF ISSUE	1 1 A