

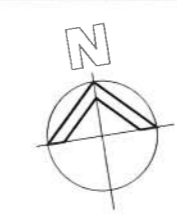


MCDOWALL STREET

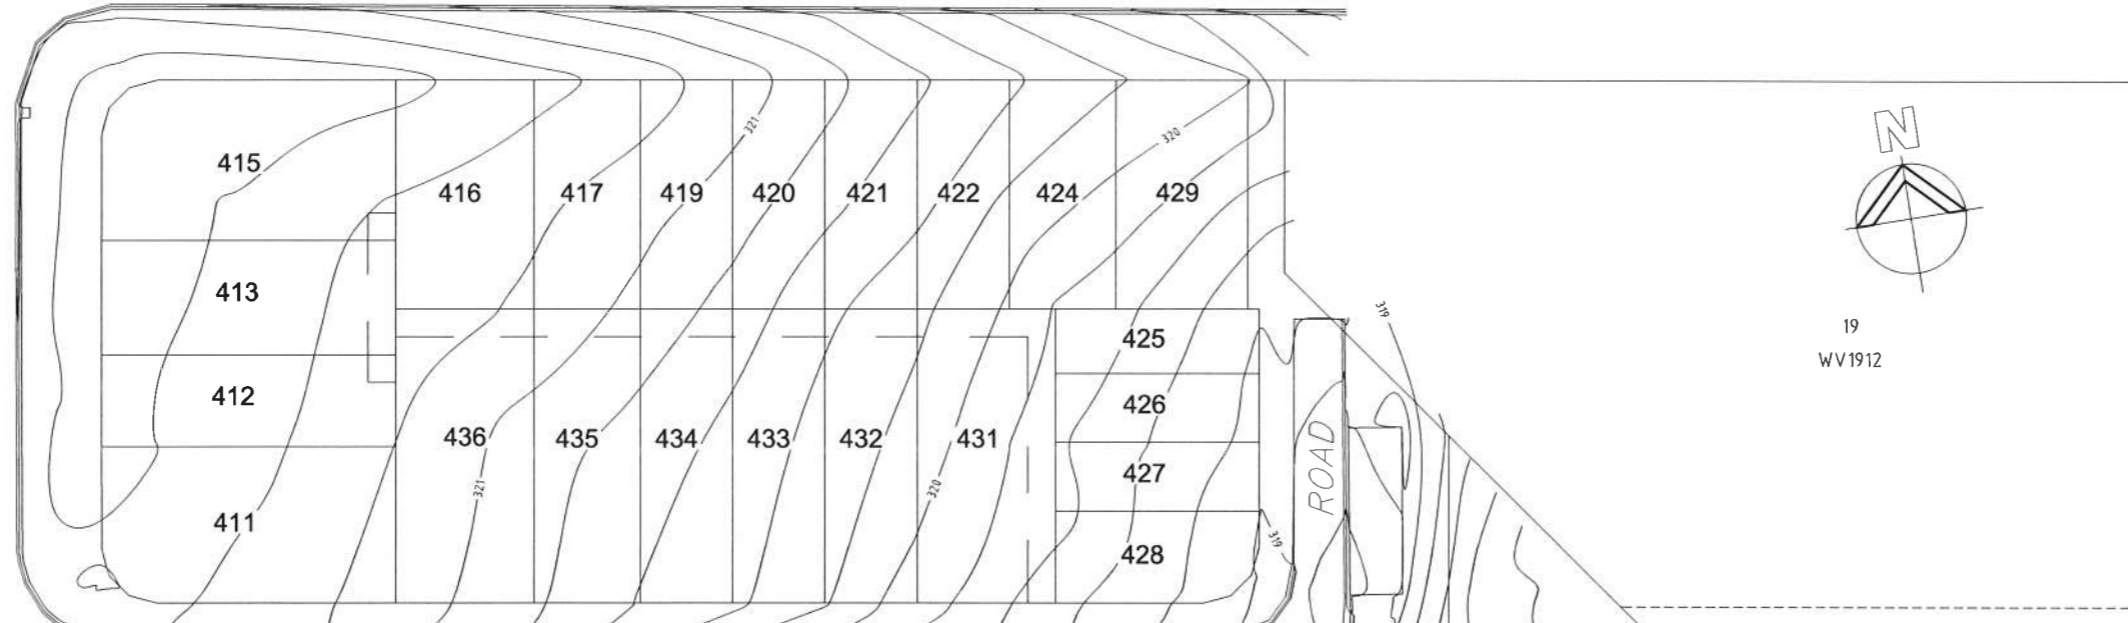

19
WV1912

CURREY STREET

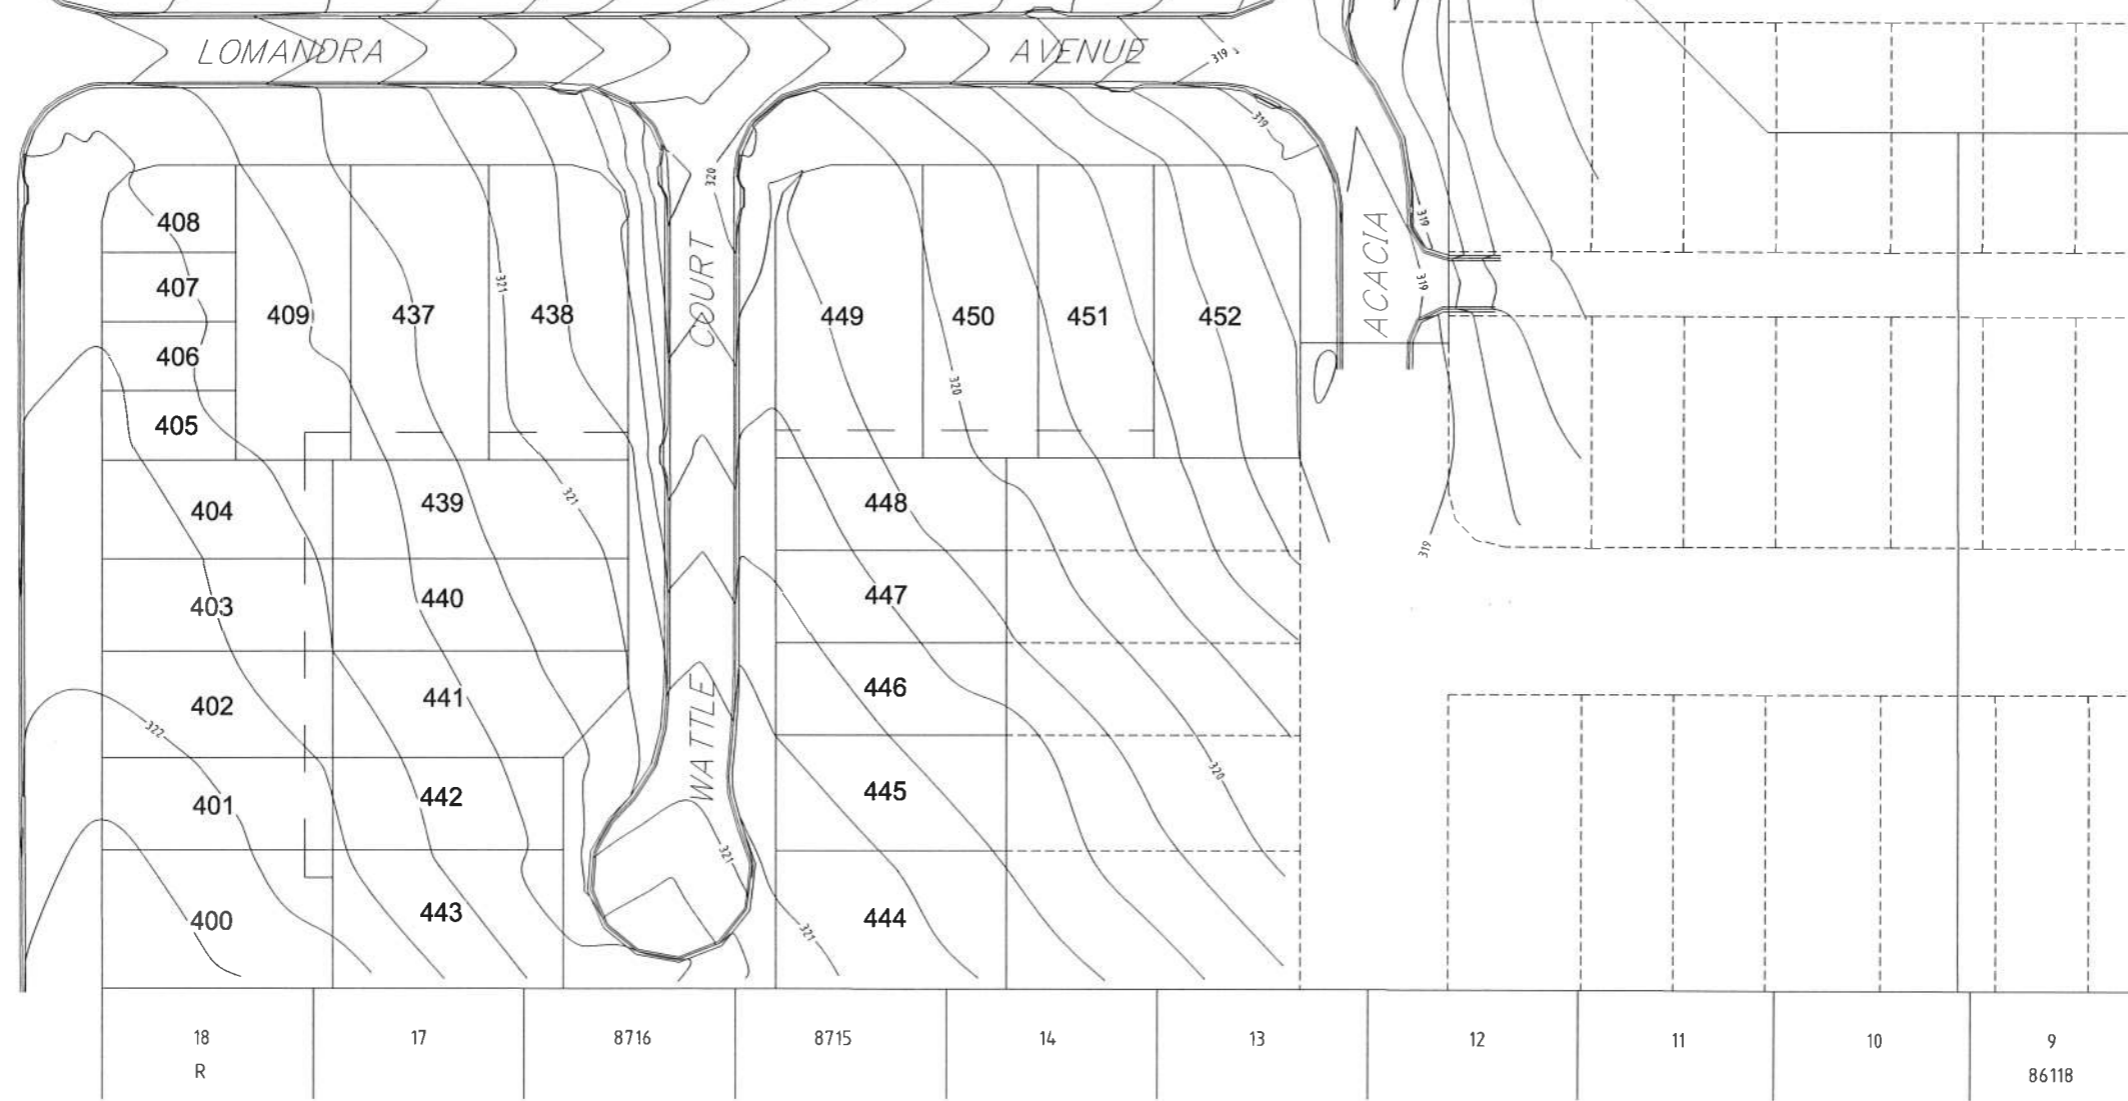

CURREY STREET

900
SP252073

132
SP249944

131
SP249944

130
SP249944

129
SP249944

124
SP249944

123
SP249944

WORKS AS CONSTRUCTED
It is certified that the original drawings have been carefully compared with the works As Constructed as to line, level and dimensions and it has been accurately amended as required so as to constitute a true and correct record of the works As Constructed.

Signature.....Date.....
Name of Signatory.....
RPEQ No.....
BRADFORD LEES PTY LTD

ISSUE	DATE	AUTHOR	COMMENTS
A	28/05/2013	T.JL	FINAL


Works As Constructed
Fyfe Pty Ltd (A.B.N. 57 008 116 130) hereby certifies that the Company has surveyed the position and level of the services shown on this plan and that the "as constructed" information is accurate.
John P. Monaghan
Surveyor
Date: 22-11-2013

FYFE PTY LTD
56 BUNGIL STREET
ROMA QLD 4455
PO BOX 19
ROMA QLD 4455
TELEPHONE 61 7 4622 2777
FACSIMILE 61 7 4622 3766
info@fyfe.com.au
www.fyfe.com.au

CLIENT
J K CIVIL CONTRACTING PTY LTD
PROJECT
**CLEARVIEW RISE - STAGES 4A & 4B
AS CONSTRUCTED CONTOURS**

ASSOCIATE CONSULTANT
BRADLEES CIVIL CONSULTING
LOCAL GOVERNMENT
MARANOVA REGIONAL COUNCIL
SCALE
0 10 20 30 40
SCALE: 1:400 (A1 PAPER SIZE)

DATUM		AHDD	
LEVEL ORIGIN	PSM 181325 RL 321.423m	CONTOUR INTERVAL	0.2m
FILE REFERENCE	37748-15-14	DRAWN	AL
CHECKED	T.JL	DATE	17/05/2013
APPROVED	JDM	DATE	28/05/2013
PLAN NUMBER	37748_AS_CON_ST4	SHEET	OF
		1	1
			A

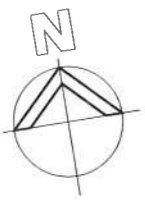


MCDOWALL STREET

WORKS AS CONSTRUCTED
 It is certified that the original drawings have been carefully compared with the works As Constructed as to line, level and dimensions and it has been accurately amended as required so as to constitute a true and correct record of the works As Constructed.

Signature..... Date.....
 Name of Signatory.....
 RPEQ No.....
 BRADFORD LEES PTY LTD

900
SP252073

CURREY STREET

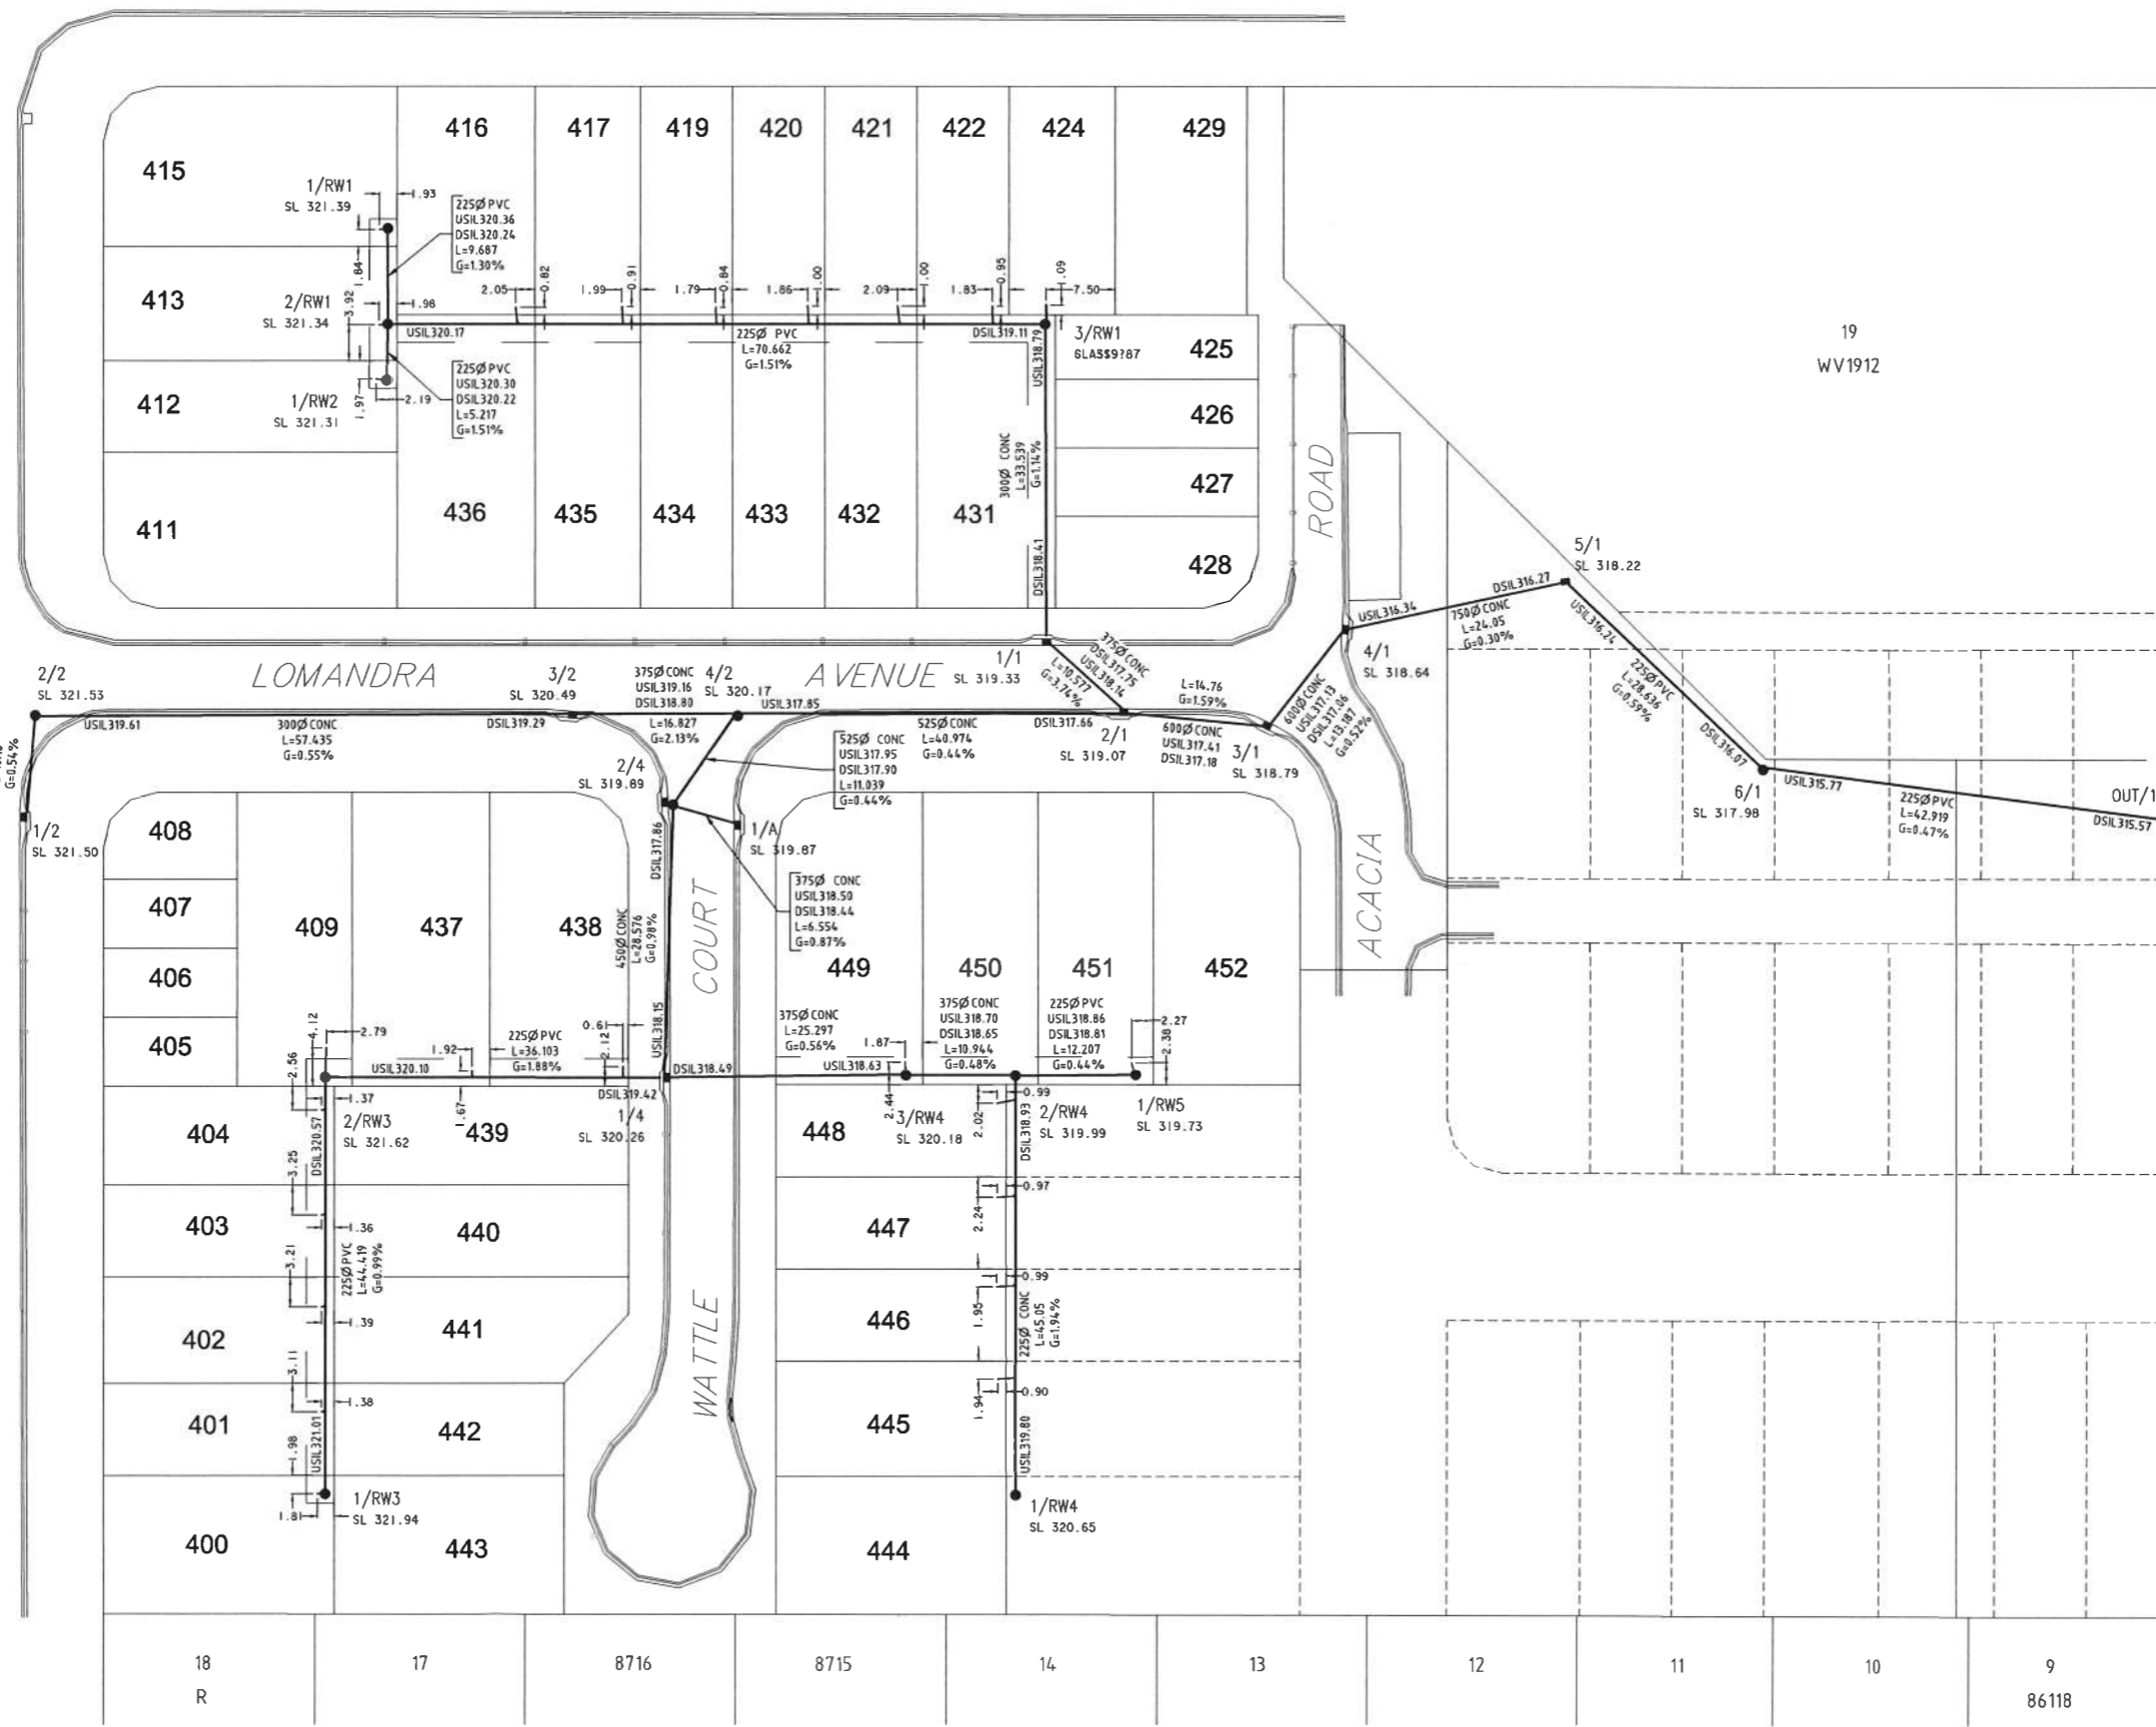

132 SP249944
 131 SP249944
 130 SP249944
 129 SP249944
 124 SP249944
 123 SP249944

19
WV1912

ISSUE	DATE	AUTHOR	COMMENTS
A	29/05/2013	TJL	FINAL


Works As Constructed
 Fyfe Pty Ltd (A.B.N. 57 008 116 130) hereby certifies that the Company has surveyed the position and level of the services shown on this plan and that the "as constructed" information is accurate.
 Surveyor: *John P. Mann*
 Date: 22-11-2013


FYFE PTY LTD
 56 BUNGL STREET
 ROMA QLD 4455
 PO BOX 79
 ROMA QLD 4455
 TELEPHONE 61 7 4622 2777
 FACSIMILE 61 7 4622 7766
 info@fyfe.com.au
 www.fyfe.com.au

J K CIVIL CONTRACTING PTY LTD
 PROJECT: CLEARVIEW RISE - STAGES 4A & 4B AS CONSTRUCTED STORMWATER & KERB

ASSOCIATE CONSULTANT
BRADLEES CIVIL CONSULTING
 LOCAL GOVERNMENT
MARANOA REGIONAL COUNCIL

DATUM		AHDD	
LEVEL ORIGIN	PSM 181325 RL 321423m	CONTOUR INTERVAL	
FILE REFERENCE	37748-15-14	DRAWN	AL
		DATE	17/05/2013
CHECKED	TJL	DATE	29/05/2013
APPROVED	JDM	DATE	29/05/2013
PLAN NUMBER	37748_AS_SW_ST4	SHEET	OF
		1	1
			A

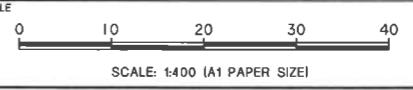

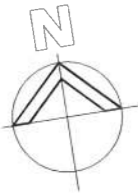

MCDOWALL STREET

WORKS AS CONSTRUCTED


It is certified that the original drawings have been carefully compared with the works As Constructed as to line, level and dimensions and it has been accurately amended as required so as to constitute a true and correct record of the works As Constructed.

Signature.....Date.....

Name of Signatory.....

RPEQ No.....

BRADFORD LEES PTY LTD

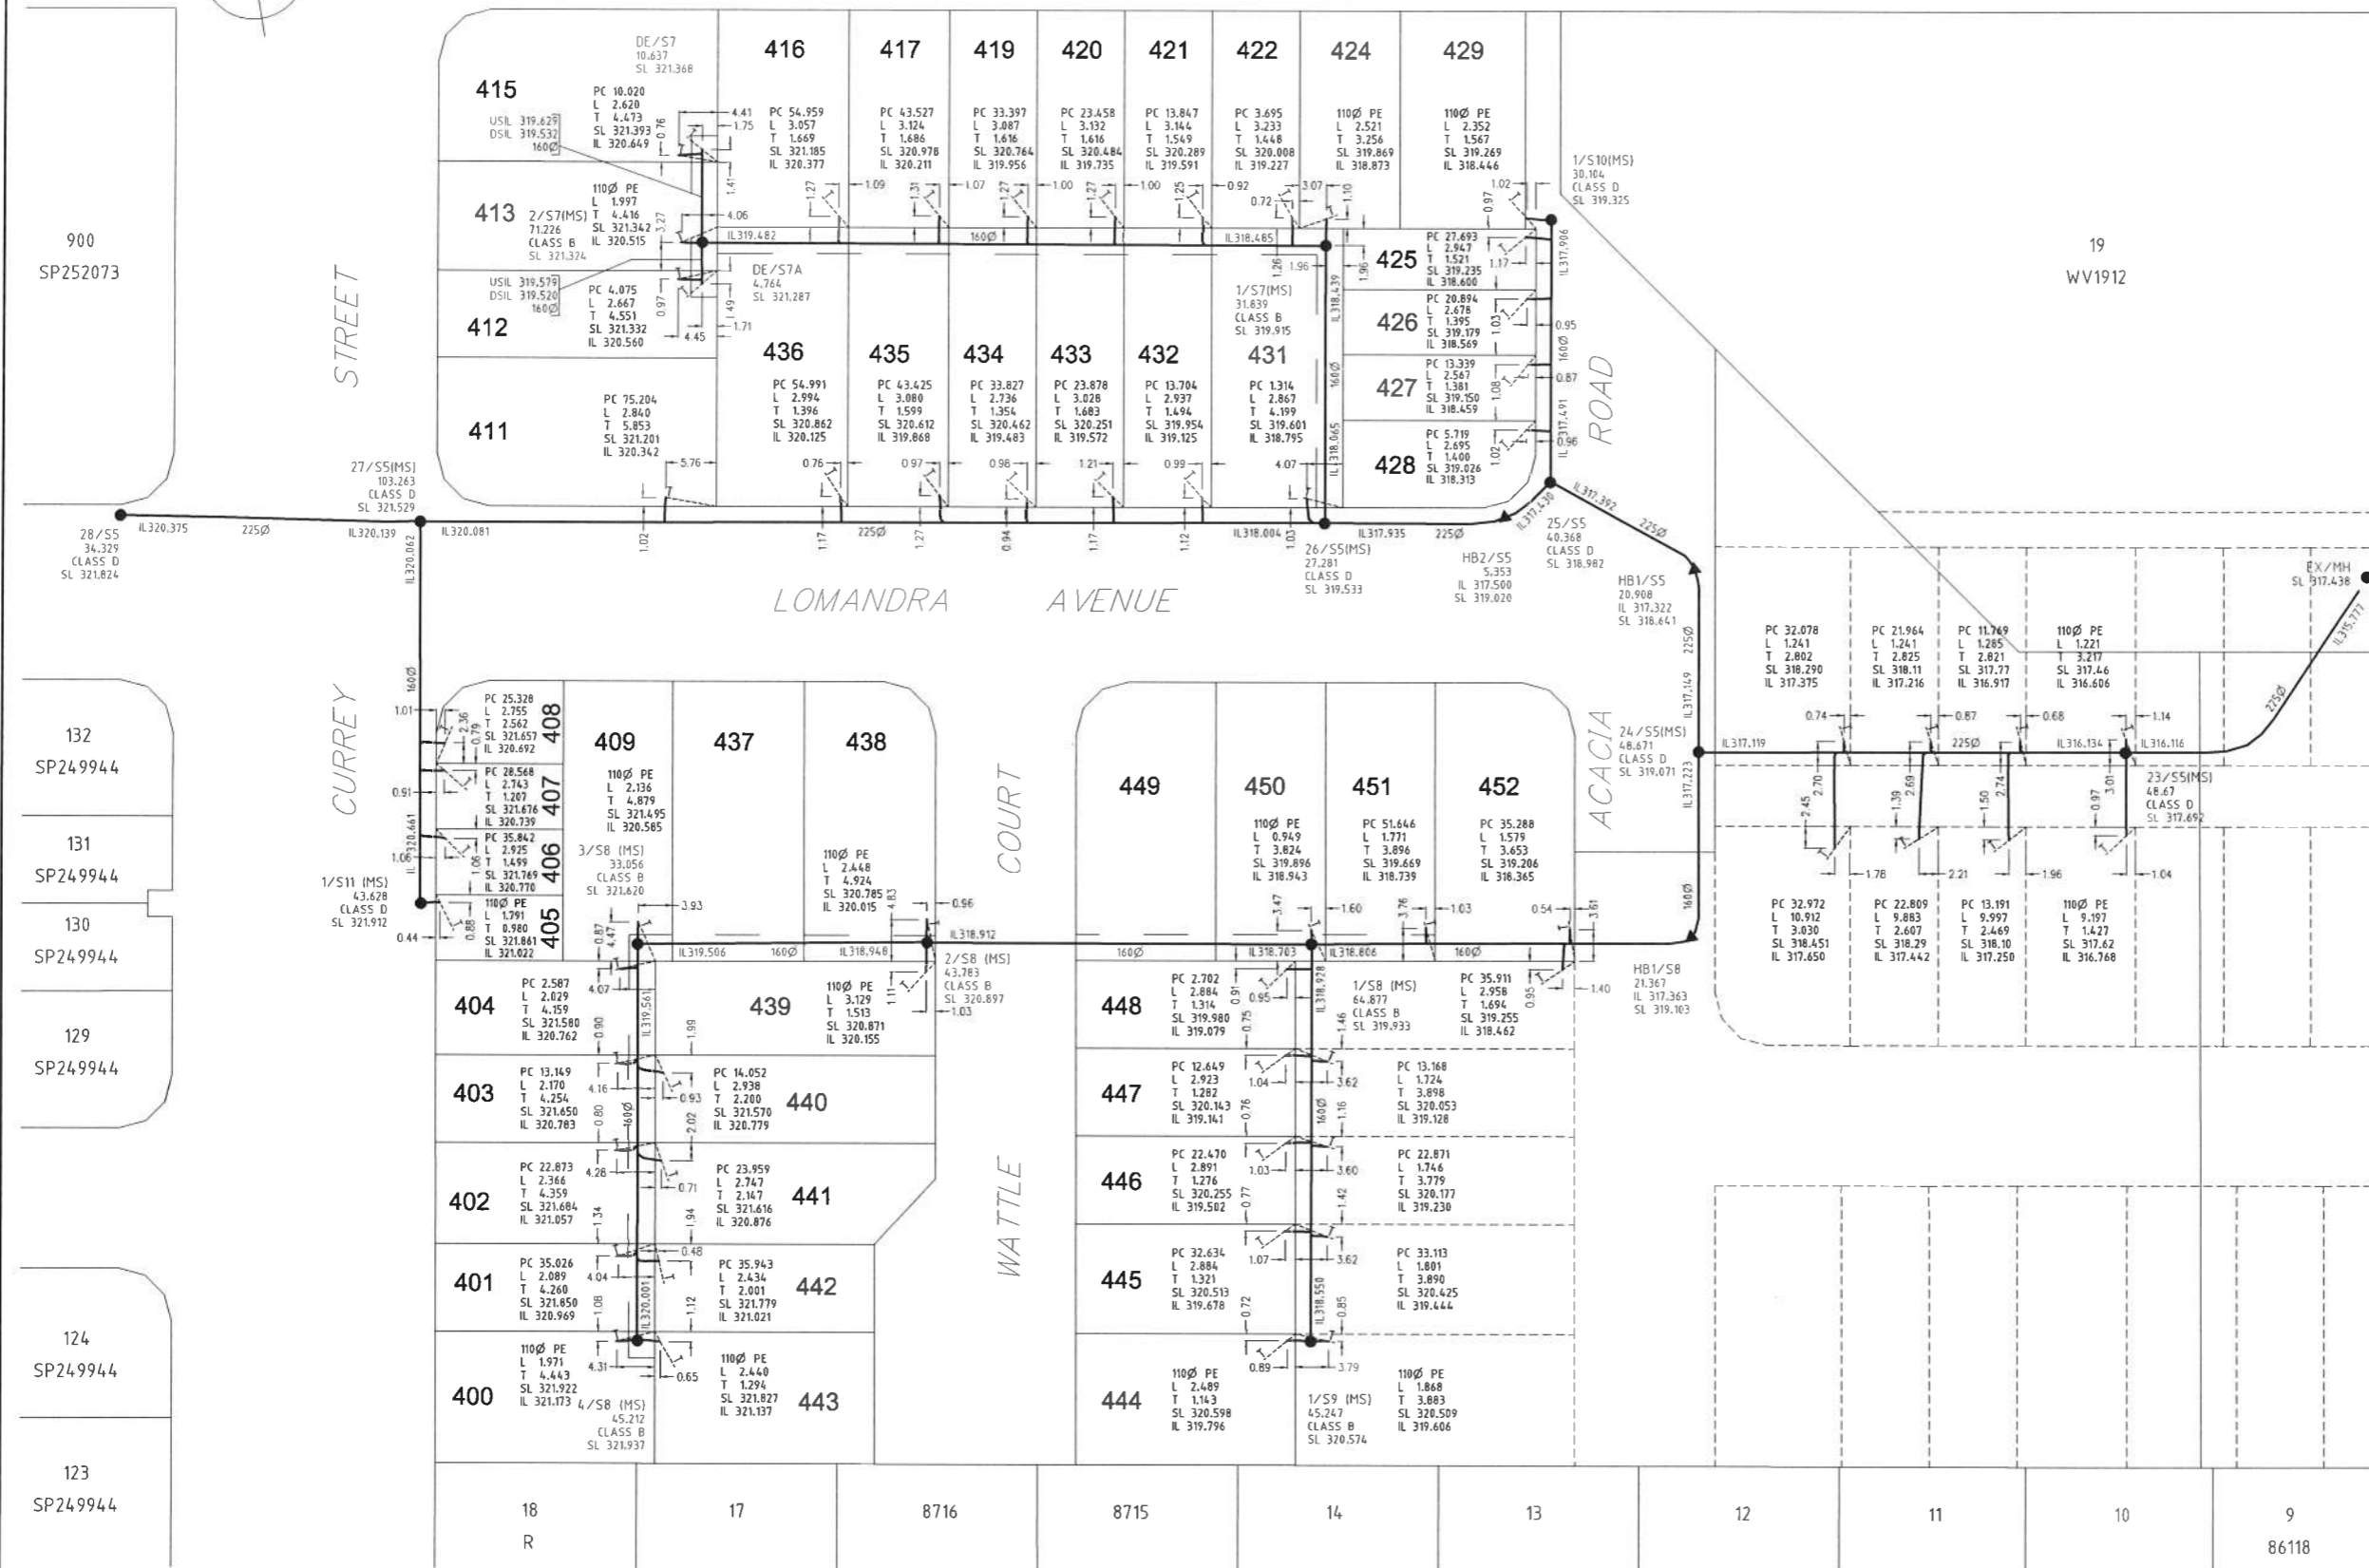

ISSUE	DATE	AUTHOR	COMMENTS
A	28/05/2013	T.J.L	FINAL
B	22/11/2013	AL	LEVEL ADDED

Works As Constructed
 Fyfe Pty Ltd (A.B.N. 57 008 116 130) hereby certifies that the Company has surveyed the position and level of the services shown on this plan and that the "as constructed" information is accurate.
 Surveyed by *John J. Munro*
 Date: 22-11-2013


FYFE PTY LTD
 56 BUNGL STREET
 ROMA QLD 4455
 PO BOX 79
 ROMA QLD 4455
 TELEPHONE 61 7 4622 2777
 FACSIMILE 61 7 4622 7766
 info@fyfe.com.au
 www.fyfe.com.au

CLIENT
J K CIVIL CONTRACTING PTY LTD
 PROJECT
CLEARVIEW RISE - STAGES 4A & 4B AS CONSTRUCTED SEWERAGE

ASSOCIATE CONSULTANT
BRADLEES CIVIL CONSULTING
 LOCAL GOVERNMENT
MARANOVA REGIONAL COUNCIL
 SCALE

 SCALE: 1:400 (A1 PAPER SIZE)

DATUM	AHDD
LEVEL ORIGIN	PSM 181325 RL 321.423m
CONTOUR INTERVAL	-
FILE REFERENCE	37748-15-14
DRAWN	AL
DATE	17/05/2013
CHECKED	T.J.L
DATE	28/05/2013
APPROVED	JDM
DATE	28/05/2013
PLAN NUMBER	37748_AS_SEW_ST4_B
SHEET	1
OF	1
ISSUE	B

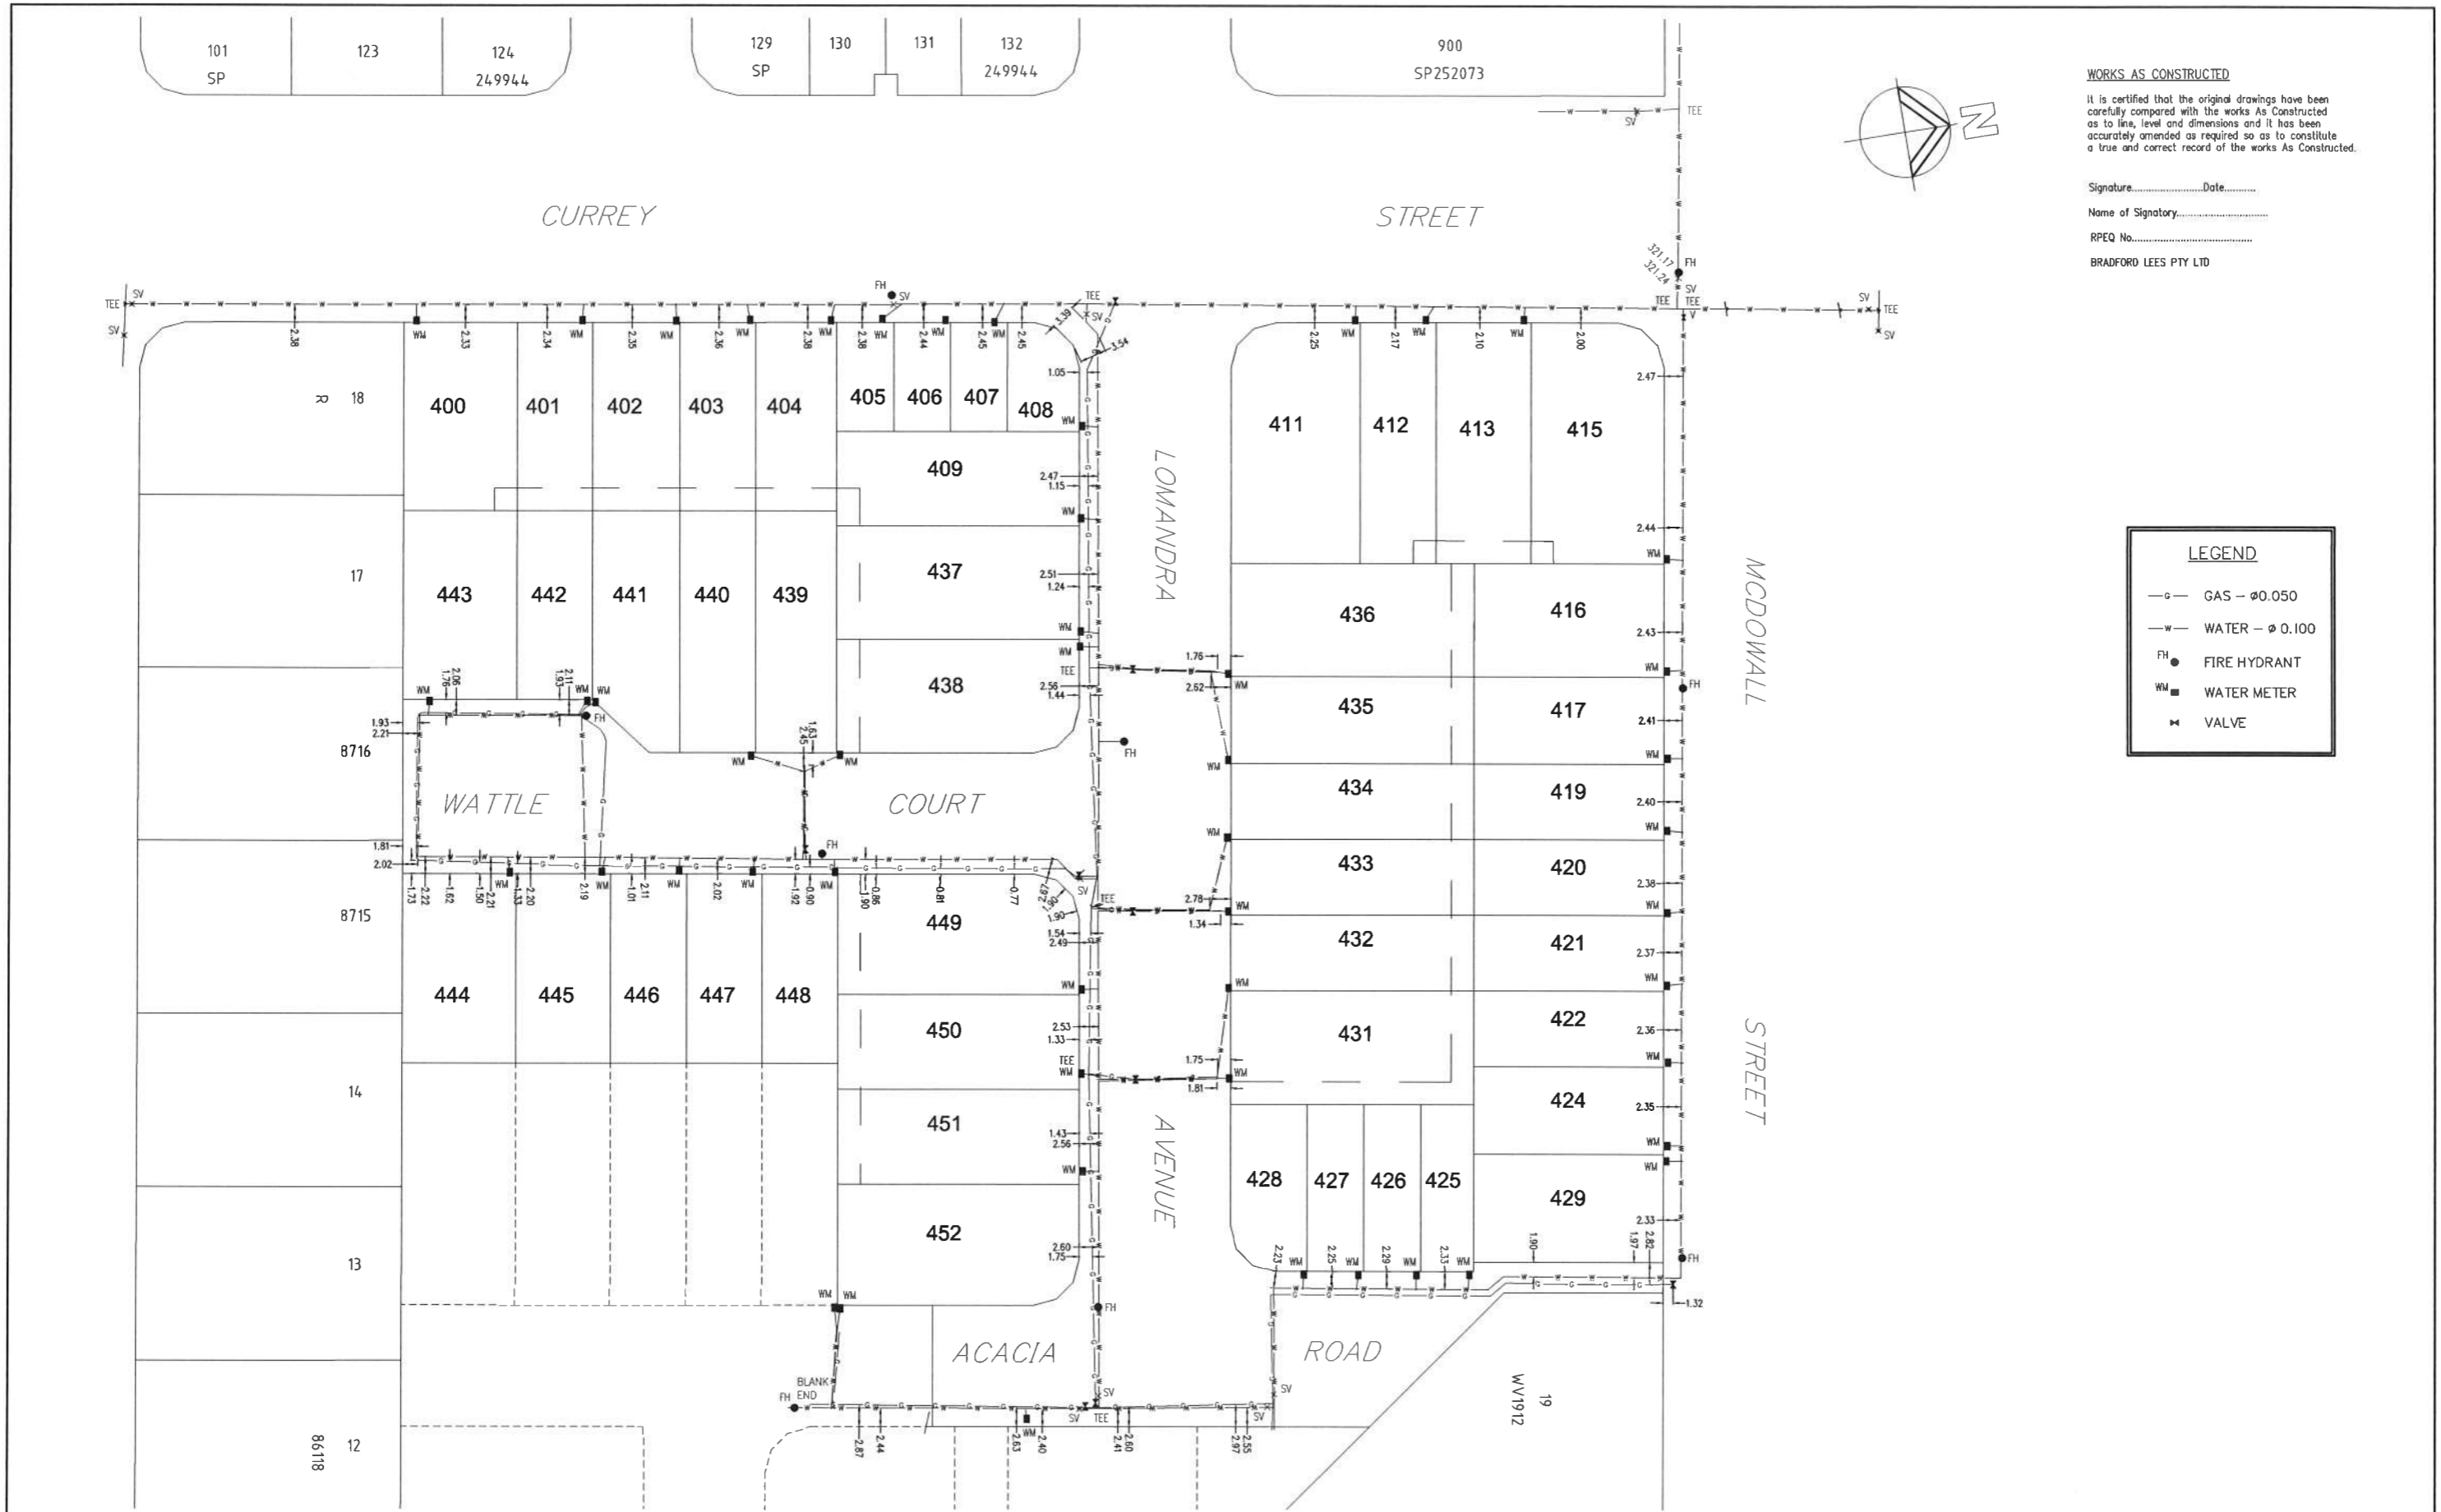

WORKS AS CONSTRUCTED
 It is certified that the original drawings have been carefully compared with the works As Constructed as to line, level and dimensions and it has been accurately amended as required so as to constitute a true and correct record of the works As Constructed.

Signature.....Date.....
 Name of Signatory.....
 RPEQ No.....
 BRADFORD LEES PTY LTD

LEGEND

- G— GAS — Ø0.050
- W— WATER — Ø 0.100
- FH ● FIRE HYDRANT
- WM ■ WATER METER
- ⋈ VALVE

ISSUE	DATE	AUTHOR	COMMENTS
A	30/05/2013	T.J.L	FINAL
B	21/11/2013	AL	CIVIL ENGINEERS AMENDMENTS

Works As Constructed
 Fyfe Pty Ltd (A.B.N. 57 008 116 130) hereby certifies that the Company has surveyed the position and level of the services shown on this plan and that the "as constructed" information is accurate.
 Surveyed by *John J. Munro*
 Date: **22-11-2013**

FYFE PTY LTD
 56 BUNCL STREET
 ROMA QLD 4455
 PO BOX 79
 ROMA QLD 4455
 TELEPHONE 61 7 4622 2777
 FACSIMILE 61 7 4622 7766
 info@fyfe.com.au
 www.fyfe.com.au

J K CIVIL CONTRACTING PTY LTD
 PROJECT: **CLEARVIEW RISE - STAGES 4A & 4B AS CONSTRUCTED GAS & WATER**

ASSOCIATE CONSULTANT
BRADLEES CIVIL CONSULTING
 LOCAL GOVERNMENT
MARANOA REGIONAL COUNCIL

DATUM		AHDD	
LEVEL ORIGIN	PSM 181325	RL	321.423m
CONTOUR INTERVAL —			
FILE REFERENCE	37748-15-14		
DRAWN	AL	DATE	17/05/2013
CHECKED	T.J.L	DATE	28/05/2013
APPROVED	JDM	DATE	30/05/2013
PLAN NUMBER	37748_AS_WTR_ST4_B	SHEET OF	ISSUE
		1	B

