




AS CONSTRUCTED - SEWER

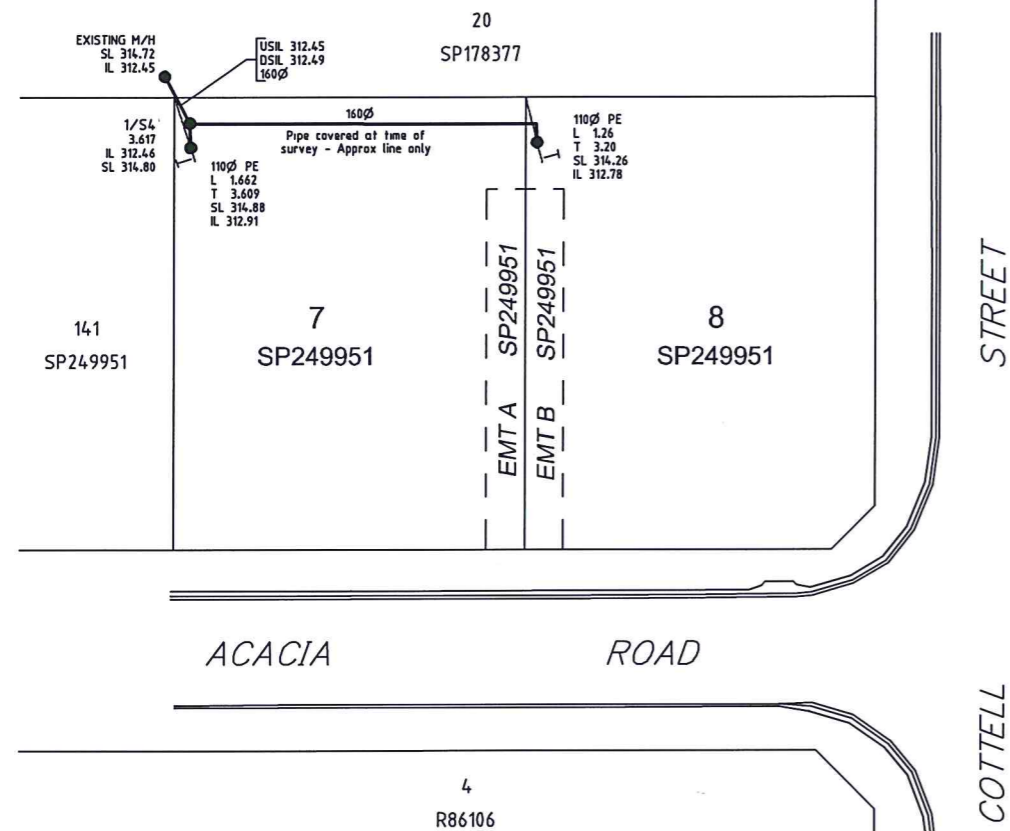


AS CONSTRUCTED - STORMWATER

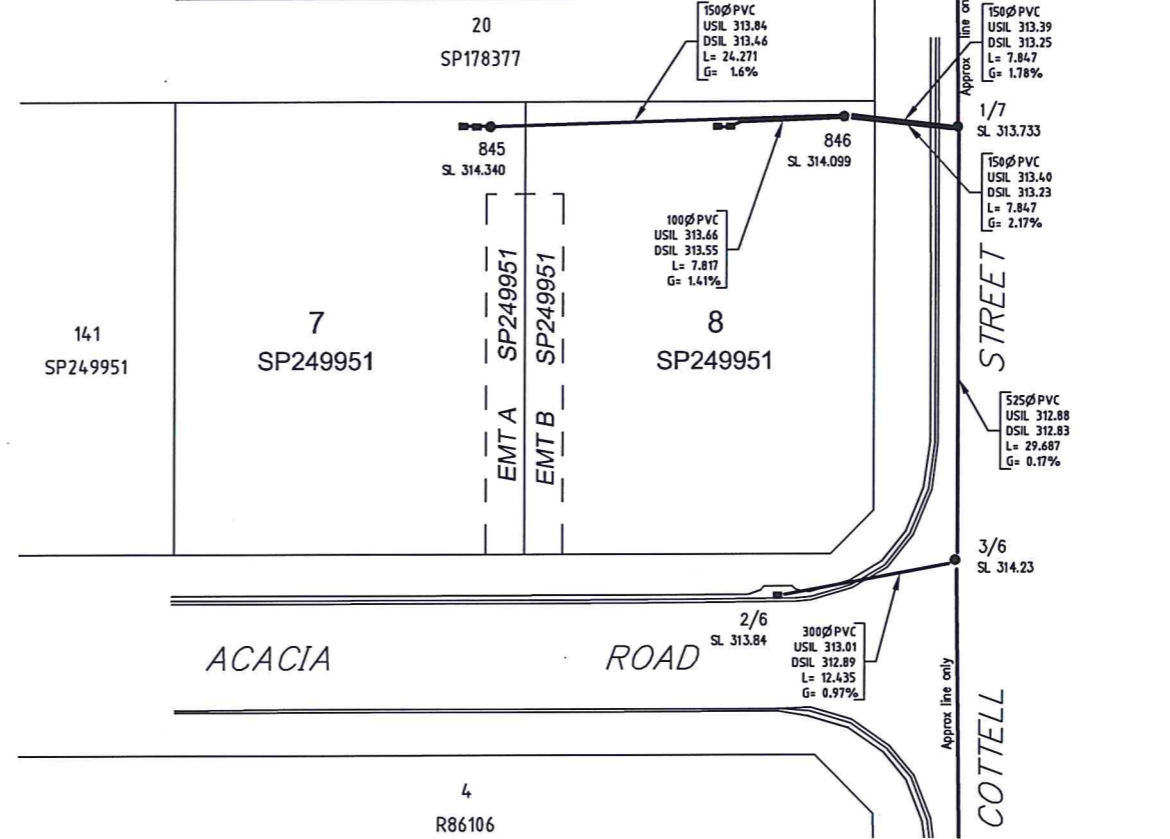


WORKS AS CONSTRUCTED
 It is certified that the original drawings have been carefully compared with the works As Constructed as to line, level and dimensions and it has been accurately amended as required so as to constitute a true and correct record of the works As Constructed.
 Signature: *[Signature]* Date: 6/3/14
 Name of Signatory: Jason M. M. M. M.
 RPEQ No. 6336
 BRADFORD LEES PTY LTD

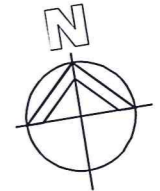

AS CONSTRUCTED - CONTOURS

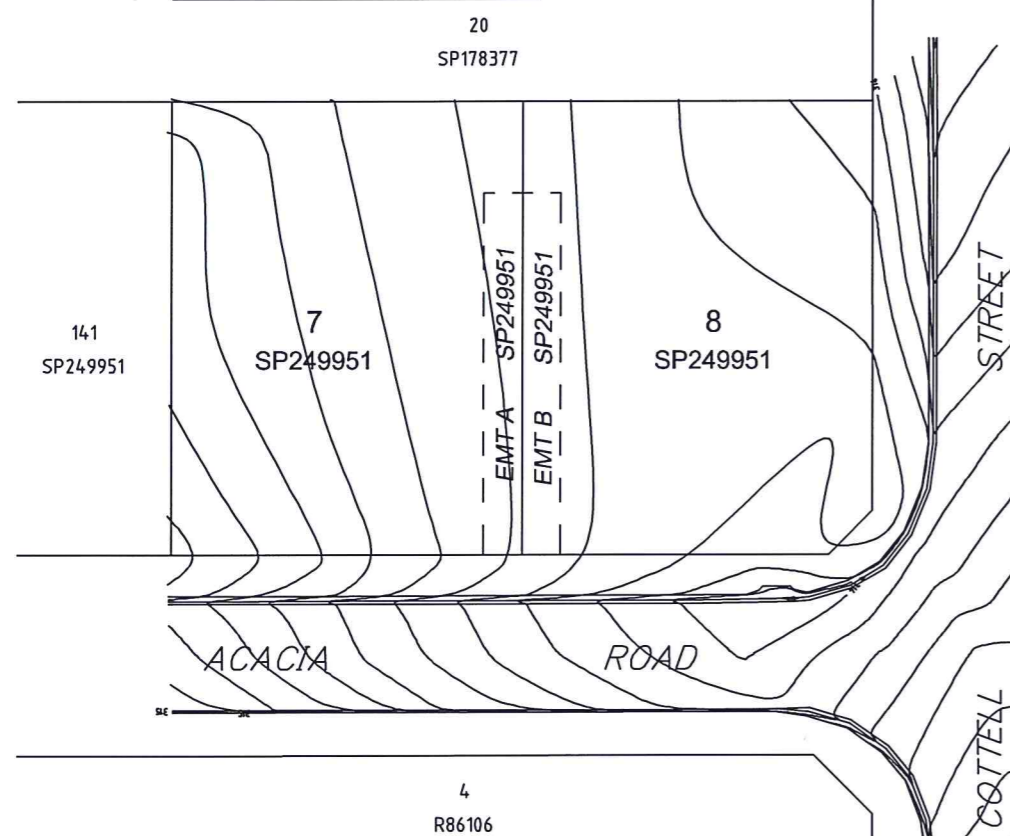

AS CONSTRUCTED - WATER AND GAS

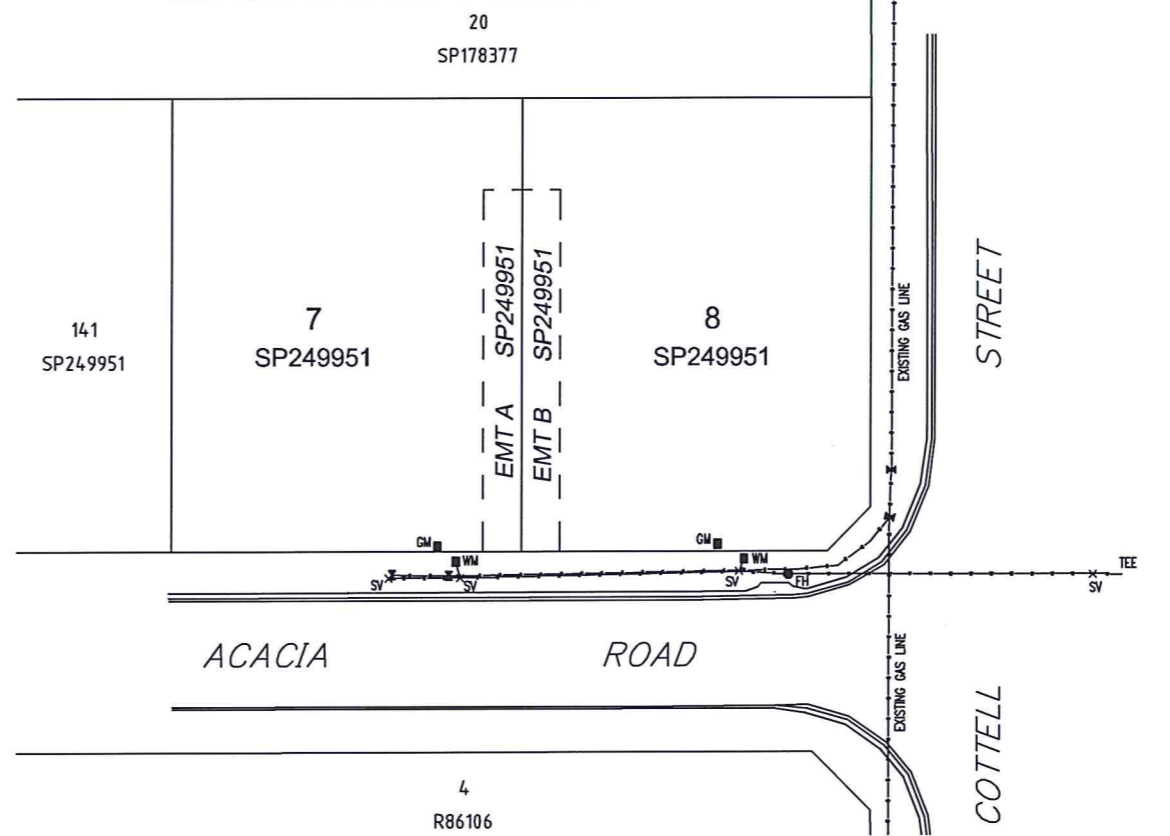

LEGEND	
	GAS - Ø0.100
	WATER - Ø0.150
	FH FIRE HYDRANT
	WM WATER METER
	GM GAS METER
	V VALVE

ISSUE	DATE	AUTHOR	COMMENTS
A	29/11/2013	AL	FINAL

Works As Constructed
 Fyfe Pty Ltd (A.B.N. 57 008 116 130) hereby certifies that the Company has surveyed the position and level of the services shown on this plan and that the "as constructed" information is accurate.
 Surveyor: *[Signature]*
 Date: 17-02-2014

FYFE PTY LTD
 56 BUNGIL STREET
 ROMA QLD 4455
 PO BOX 79
 ROMA QLD 4455
 TELEPHONE 61 7 4622 2777
 FACSIMILE 61 7 4622 7766
 info@fyfe.com.au
 www.fyfe.com.au

J K CIVIL CONTRACTING PTY LTD
 PROJECT: CLEARVIEW RISE - LOTS 7 & 8 AS CONSTRUCTED

ASSOCIATE CONSULTANT: BRADLEES CIVIL CONSULTING
 LOCAL GOVERNMENT: MARANOA REGIONAL COUNCIL
 SCALE: 1:250 (at A1) - Lengths are in Metres.

DATUM		AHDD	
LEVEL ORIGIN	PSM 181325	RL	321.423m
CONTOUR INTERVAL	0.2m		
FILE REFERENCE	37748-18-1		
DRAWN	AL	DATE	29/11/2013
CHECKED	JDM	DATE	29/11/2013
APPROVED	JDM	DATE	29/11/2013
PLAN NUMBER	37748_ASCON_LOTS_7&8	SHEET	OF
		1	1
			A