


CONDUIT CONFIGURATION

CONDUITS AND DUCTS ARE IN LAYER:
 < L460 NBN Support - Underground >
 AND TERMINOLOGY CATEGORISED INTO TWO GROUPS IN THE DRAWINGS AS PER BELOW:
 1-DUCT USED WITH LOCAL NETWORK
 2-CONDUIT USED WITH LEAD-IN DROPS
 ATTRIBUTES ATTACHED TO CONDUITS ARE AS SHOWN

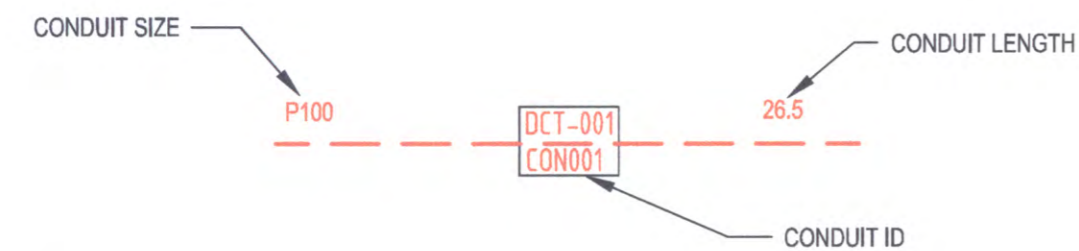

NOTE:
 - P100 HAS AN INTERNAL DIAMETER OF 104.9 mm AND A MINIMUM WALL THICKNESS OF 4.5 mm
 - P50 HAS AN INTERNAL DIAMETER OF 53 mm AND A MINIMUM WALL THICKNESS OF 3.1 mm
 - P20 HAS AN INTERNAL DIAMETER OF 23.3 mm AND A MINIMUM WALL THICKNESS OF 1.4 mm

LEGEND

- | | | | |
|--|--|--|--|
| | TRANSFORMER / KIOSK / PAD MOUNT SUB-STATION / POLE MOUNT TRANSFORMER | | SHARED TRENCH |
| | FIBRE DISTRIBUTION HUB FDH CABINET | | ZERO LOT PROPERTY BOUNDARY |
| | ACO CABLEMATE TYPE 2 PLASTIC PIT OR SIMILAR | | END CAP CONDUIT WITH STATION NO. |
| | ACO CABLEMATE TYPE 5 PLASTIC PIT OR SIMILAR | | CAP SERVICE CONDUIT (P50/P20) P20=P23 mm NBNCo SERVICE CONDUIT |
| | ACO CABLEMATE TYPE 8 PLASTIC PIT OR SIMILAR | | LOCAL CONDUIT (P100/P50) |
| | ACO CABLEMATE TYPE 9 PLASTIC PIT OR SIMILAR | | EXISTING CONDUIT |
| | EXISTING NBNCo PIT | | NBNCo STAGE BOUNDARY |
| | | | NBNCo LNC BOUNDARY |


NOTE:

- PITS TO BE LOCATED CLEAR OF THE ERGON PILLAR EXCLUSION ZONE.
- REFER TO NBN Co DOCUMENT NO. NBN-TE-CTO-194 (DEPLOYMENT OF THE NBN Co CONDUIT AND PIT NETWORK - GUIDELINES FOR DEVELOPERS) FOR DETAILED SPECIFICATION.
- PITS TO INCLUDE LID GASKET TO PREVENT DIRT ENTRY AND SPREADER BARS TO PREVENT PIT BUCKLING DURING BACKFILL / GROUND COMPACTION. PIT LIDS TO BE EMBOSSED WITH "NBN" AND COMPLY AS PER CLAUSE 5.3.2 OF THE ABOVE NBN Co DOCUMENT.
- SERVICE CONDUITS TO EXTEND 1m INSIDE THE FRONT PROPERTY BOUNDARY. FOR DISTANCES FROM SIDE PROPERTY BOUNDARY, REFER APPLICABLE PIT LAYOUT DETAILS OR SERVICE CONDUIT DETAIL FOR BOUNDARIES WITHOUT NBN PIT. CONTRACTORS TO THE TELECOMMUNICATIONS CAUTION TAPE TO END OF SERVICE CONDUITS AND EXTEND TO ABOVE GROUND LEVEL FOR FUTURE CONDUIT LOCATION.
- ALL CONDUITS TO ENTER AND EXIT AT NARROW ENDS OF PITS ONLY. LOCATE CONDUITS AS CENTRALLY IN PIT END WALLS AS POSSIBLE. CONDUITS SHALL NOT BE INSTALLED WITHIN 50 mm OF ANY CORNER OF THE PIT. MINIMUM SEPARATION BETWEEN CONDUITS TO BE 25 mm. INSTALL CONDUITS AND CONDUIT COLLARS (BUSHES) TO BE SQUARE AND FLUSH WITH THE PIT END WALL. REFER TO THE PIT END WALL DETAILS IN THIS DESIGN FOR ADDITIONAL REQUIREMENTS.
- MINIMUM COVER TO BE: 300 mm FOR SERVICE DROP CONDUITS, 450 mm IN VERGE, 600 mm UNDER LOCAL ROADS, AND 800 mm UNDER MAIN ROADS.
- CONDUITS ARE TO BE CLEANED AND PROVEN USING A MANDREL. AFTER TESTING INSTALL A SUITABLE DRAW ROPE TO ALL CONDUITS AND CAP CONDUIT ENDS. SEAL CONDUITS AT PITS TO PREVENT ENTRY OF DUST AND MOISTURE. SERVICE CONDUIT DRAW ROPES TO BE ADDITIONALLY FITTED WITH A PLASTIC LABEL AT PIT END, IDENTIFYING LOT NUMBER AND DISTANCE / DIRECTION FROM BOUNDARY.
- INSTALL NON CONDUCTIVE (METAL FREE) MARKER TAPE ABOVE ALL NBN Co CONDUITS, 300 mm BELOW FINISHED GROUND LEVEL. INSTALL METALLIC KERB MARKERS AT ROAD CROSSINGS.
- REFER TO ERGON ENERGY STANDARD DRAWINGS 5228 AND 5168 SHEETS 1 TO 3 FOR SHARED TRENCH CROSS SECTIONS.
- GRADE TOP OF PIT TO MATCH VERGE / FOOTPATH.
- THERE ARE A TOTAL OF 23 RESIDENTIAL DWELLINGS OVER 23 LOTS, MADE UP OF 23 SINGLE DWELLING UNITS.
- ALL OF THE STAGE IS TO BE FED FROM EXISTING FDH INSTALLED IN STAGE 1A. REFER TO NBN Co PROJECT NO: AYCA-E0ERS FOR DETAILS.
- WHERE REQUIRED, SUPPLY AND INSTALL SERVICE AND ROAD CROSSING CONDUITS SHOWN IN THE PIT LAYOUTS.
- SUPPLY AND INSTALL ADDITIONAL DEVIATING CONDUIT BENDS TO ACHIEVE THE INCREASED / DECREASED BURIAL DEPTH REQUIRED TO AVOID CLASH WITH OTHER SERVICES.
- WHERE SHOWN ON SITE PLAN, LOCATE EXISTING CAPPED CONDUIT FROM EXISTING PIT 'C' AT LOT 302 / 303 BOUNDARY. CUT EXISTING P100 LONGITUDINAL CONDUIT AT SUITABLE POSITION TO JOIN TO CONDUIT FROM PIT 'C' WITH A BEND. REMAINING P100 OFFCUT LONGITUDINAL CONDUIT FRONTING LOT 301, NORTH OF LOT 302 TO BE ABANDONED.
- FOR INSTALLATION OF PIT, CUT INTO EXISTING NBN Co CONDUIT AND CONNECT WITH BENDS AND TERMINATE INSIDE THE PIT. WARNING: EXISTING ELECTRICAL CONDUITS AND OTHER SERVICES EXIST ON THE WESTERN SIDE OF HANLEY STREET.
- WHERE SHOWN ON SITE PLAN, INSTALL POLYMERIC CABLE COVER STRIP COMPLYING WITH AS4702 AND CABLE MARKER TAPE ABOVE NBN Co CONDUITS INSTALLED OUT OF NORMAL TRENCH ALIGNMENT.

STAFF WORKING ON THIS ESTIMATE PLEASE NOTE:
 The location of other authorities services which may affect this work have not been obtained by the estimator. Constructor to obtain service information before commencing.

SAFETY FIRST
 SAFETY STARTS WITH YOU

AS CONSTRUCTED BY
 COASTAL ENERGY (07 5456 1800)
 PRINT: Sarah Leftwich
 SIGNED: S. Attinch
 DATE: 15/10/2014

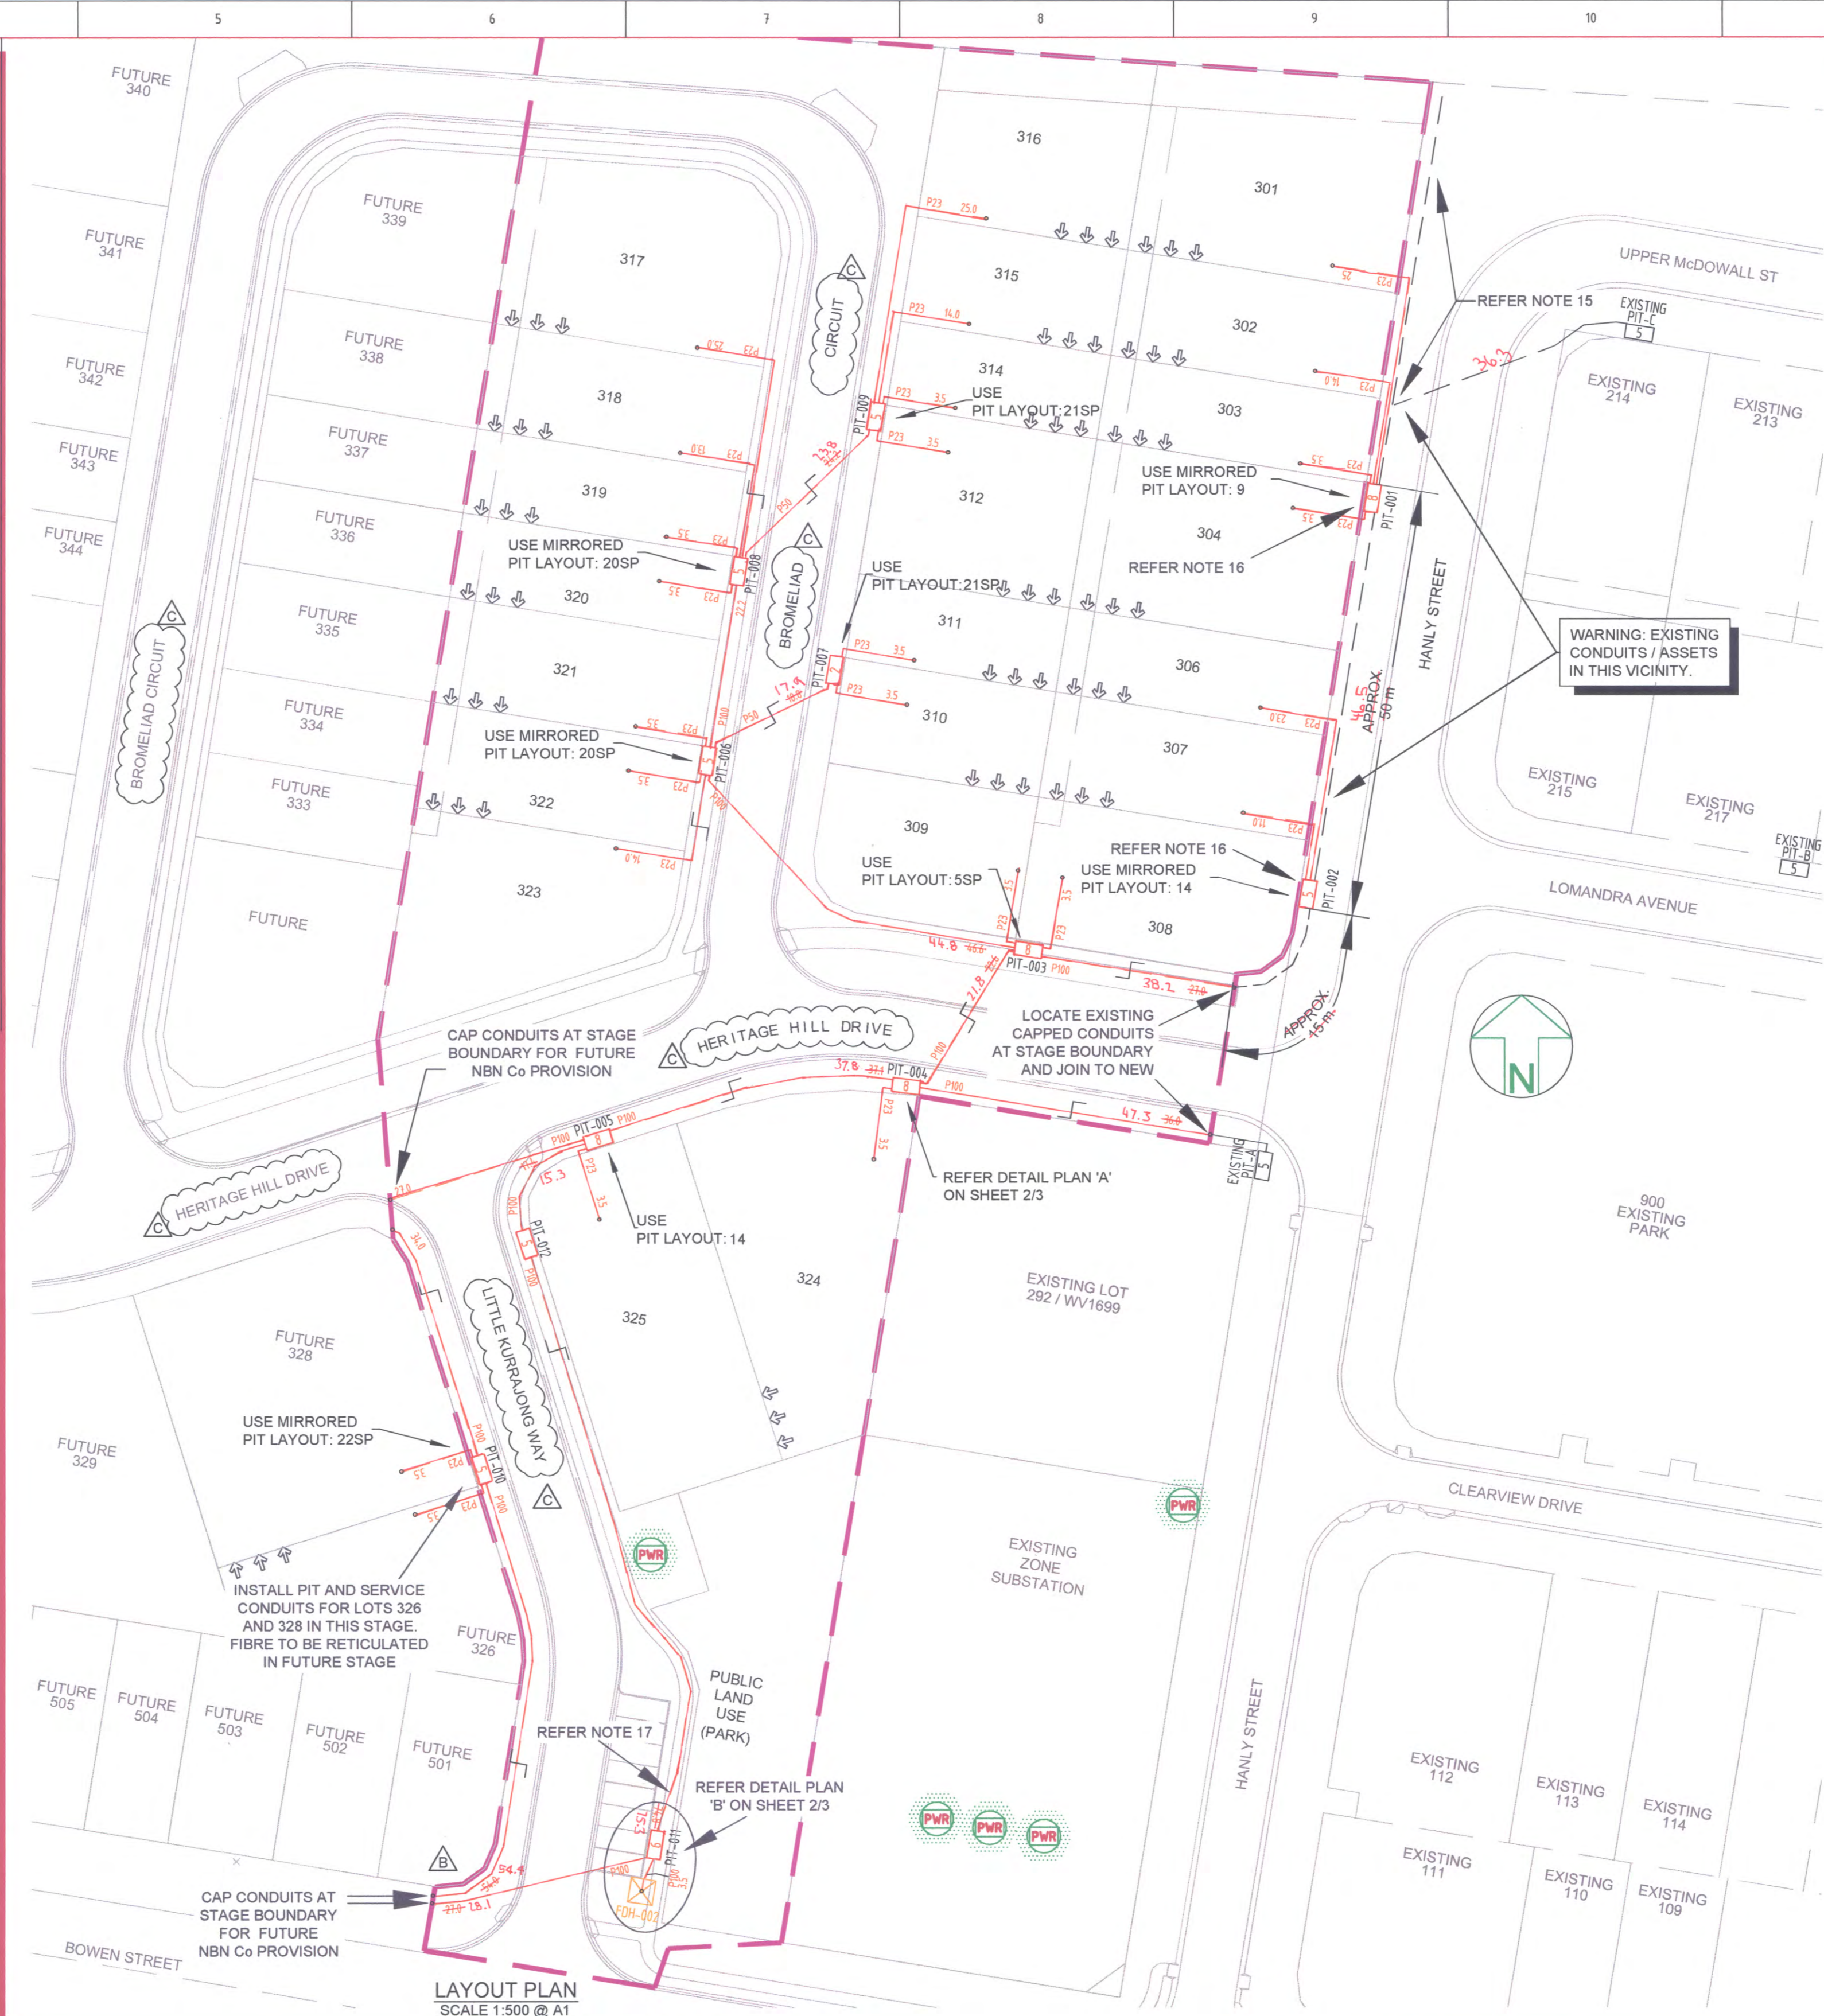

LAYOUT PLAN
 SCALE 1:500 @ A1

FOR CONSTRUCTION


****ATTENTION****
 CONSTRUCTORS DO NOT
 change or alter job
 specifications unless first
 checking with designer.

REV	DATE	DRAFTER	DESCRIPTION	APPROVED
C	13/08/14	RB	UPDATED WITH ROAD NAMES	
B	08/05/14	RB	ADDED ROAD CROSSING CONDUIT FOR FUTURE LOOP REDUNDANCY	
A	06/05/14	RB	ISSUED FOR CONSTRUCTION	
2	28/04/14	RB	ADDED FDH, FDH PIT AND PIT-012 AS PER NBN Co COMMENTS	
1	12/03/14	RB	FOR APPROVAL	

NBNCO APPROVAL RECORD:	
SIGNATURE	DATE
<input type="checkbox"/> DD	
<input type="checkbox"/> WD	
<input type="checkbox"/> AB	

QUALITY RECORD:
 NBNCO DISCLAIMER
 THIS DOCUMENT HAS BEEN PREPARED SOLELY FOR THE USE OF NBNCO LIMITED (ABN 86 136 533 741) FOR USE IN MAINTAINING NBNCO FACILITIES. IT HAS NOT BEEN CREATED FOR ANY OTHER USE. IT SHOULD NOT BE SCALED TO LOCATE NBNCO ASSETS. NO WARRANTY IS GIVEN THAT THE INFORMATION IS ACCURATE OR COMPLETE.


spa consulting engineers
 Cairns (07) 4032 5311
 Townsville (07) 4728 3025
 PO Box 894 North Cairns QLD 4870
 Email Address: admin@spaconstructing.com.au
 SPA Consulting Engineers (2012) Pty Ltd. v.1.1.0 (2012/04/04)

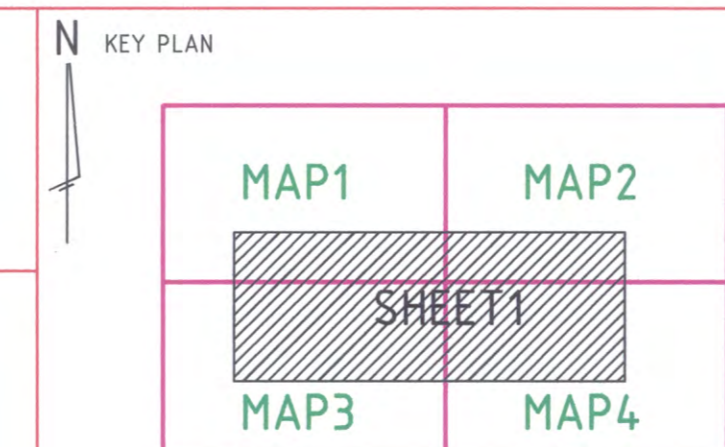

DRAWING TITLE:
 CLEARVIEW RISE STAGE 3A
 BOWEN STREET UDA
 NBN Co PIT AND PIPE DESIGN
 SITE PLAN AND NOTES

STATE: QLD	REGION: SW
FSA:	FSAM: FDA:
PROJECT No: AYCA-P6HFO	
CADREF No: 2205-T01	
SCALE: AS SHOWN	SHEET No: 1 OF 3 REV: C

SCALE	AS SHOWN
SHEET NO.	1 OF 2
CADREF. No.	2206-T01
PROJECT No.	AYCA-P6H12
FS#	FS#M
FS#A	FS#A
STATE	OLD
REGION	SW
DRAWING TITLE	SITE PLAN
CLEARVIEW RISE STAGE 3B	NBN CO PIT AND PIPE DESIGN

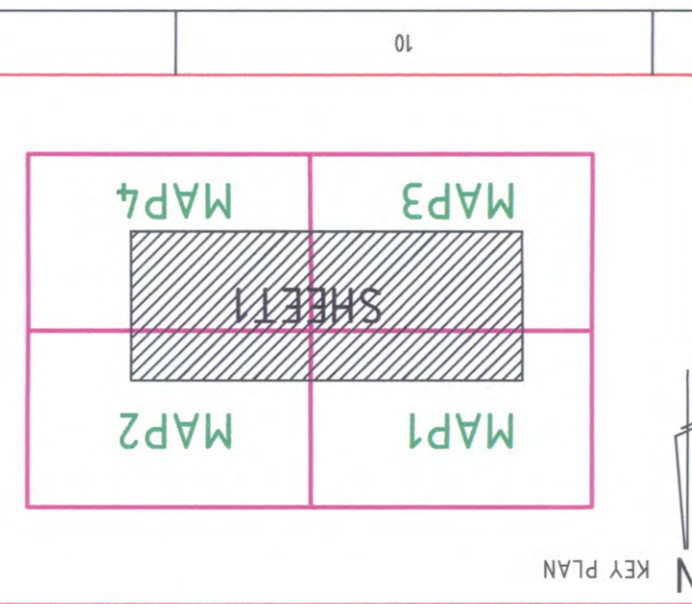

NBN CO Limited
NBN CO Limited
1400 St. Lawrence Street
Vancouver, BC V6L 1C9
Canada
Tel: (604) 275-3111
Fax: (604) 275-3112
www.nbnco.com

spa consulting engineers
spa consulting engineers
1000 West Broadway
Vancouver, BC V6H 2G6
Canada
Tel: (604) 681-4200
Fax: (604) 681-4201
www.spae.ca


NBNC APPROVAL RECORD:
SIGNATURE: _____
DATE: _____

QUALITY RECORD:
DD
WD
AB

NBNC DISCLAIMER:
THIS DOCUMENT HAS BEEN PREPARED SOLELY FOR THE USE OF NBNC LIMITED (VAN 86 136 533 741) FOR USE IN MAINTAINING NBNC FACILITIES. IT HAS NOT BEEN CREATED FOR ANY OTHER USE. IT SHOULD NOT BE USED TO LOCATE NBNC ASSETS. NO WARRANTY IS GIVEN THAT THE INFORMATION IS ACCURATE OR COMPLETE.

REV	DATE	DRAWN	DESCRIPTION
C	14/08/14	RB	UPDATED WITH ROAD NAMES
B	21/05/14	RB	ADDED / MODIFIED EXISTING TO SUIT STG. 3A DESIGN REVISIONS
A	31/03/14	RB	ISSUED FOR CONSTRUCTION
1	12/03/14	RB	FOR APPROVAL

****ATTENTION****
CONSTRUCTORS DO NOT
change or alter job
specifications unless first
checking with designer.

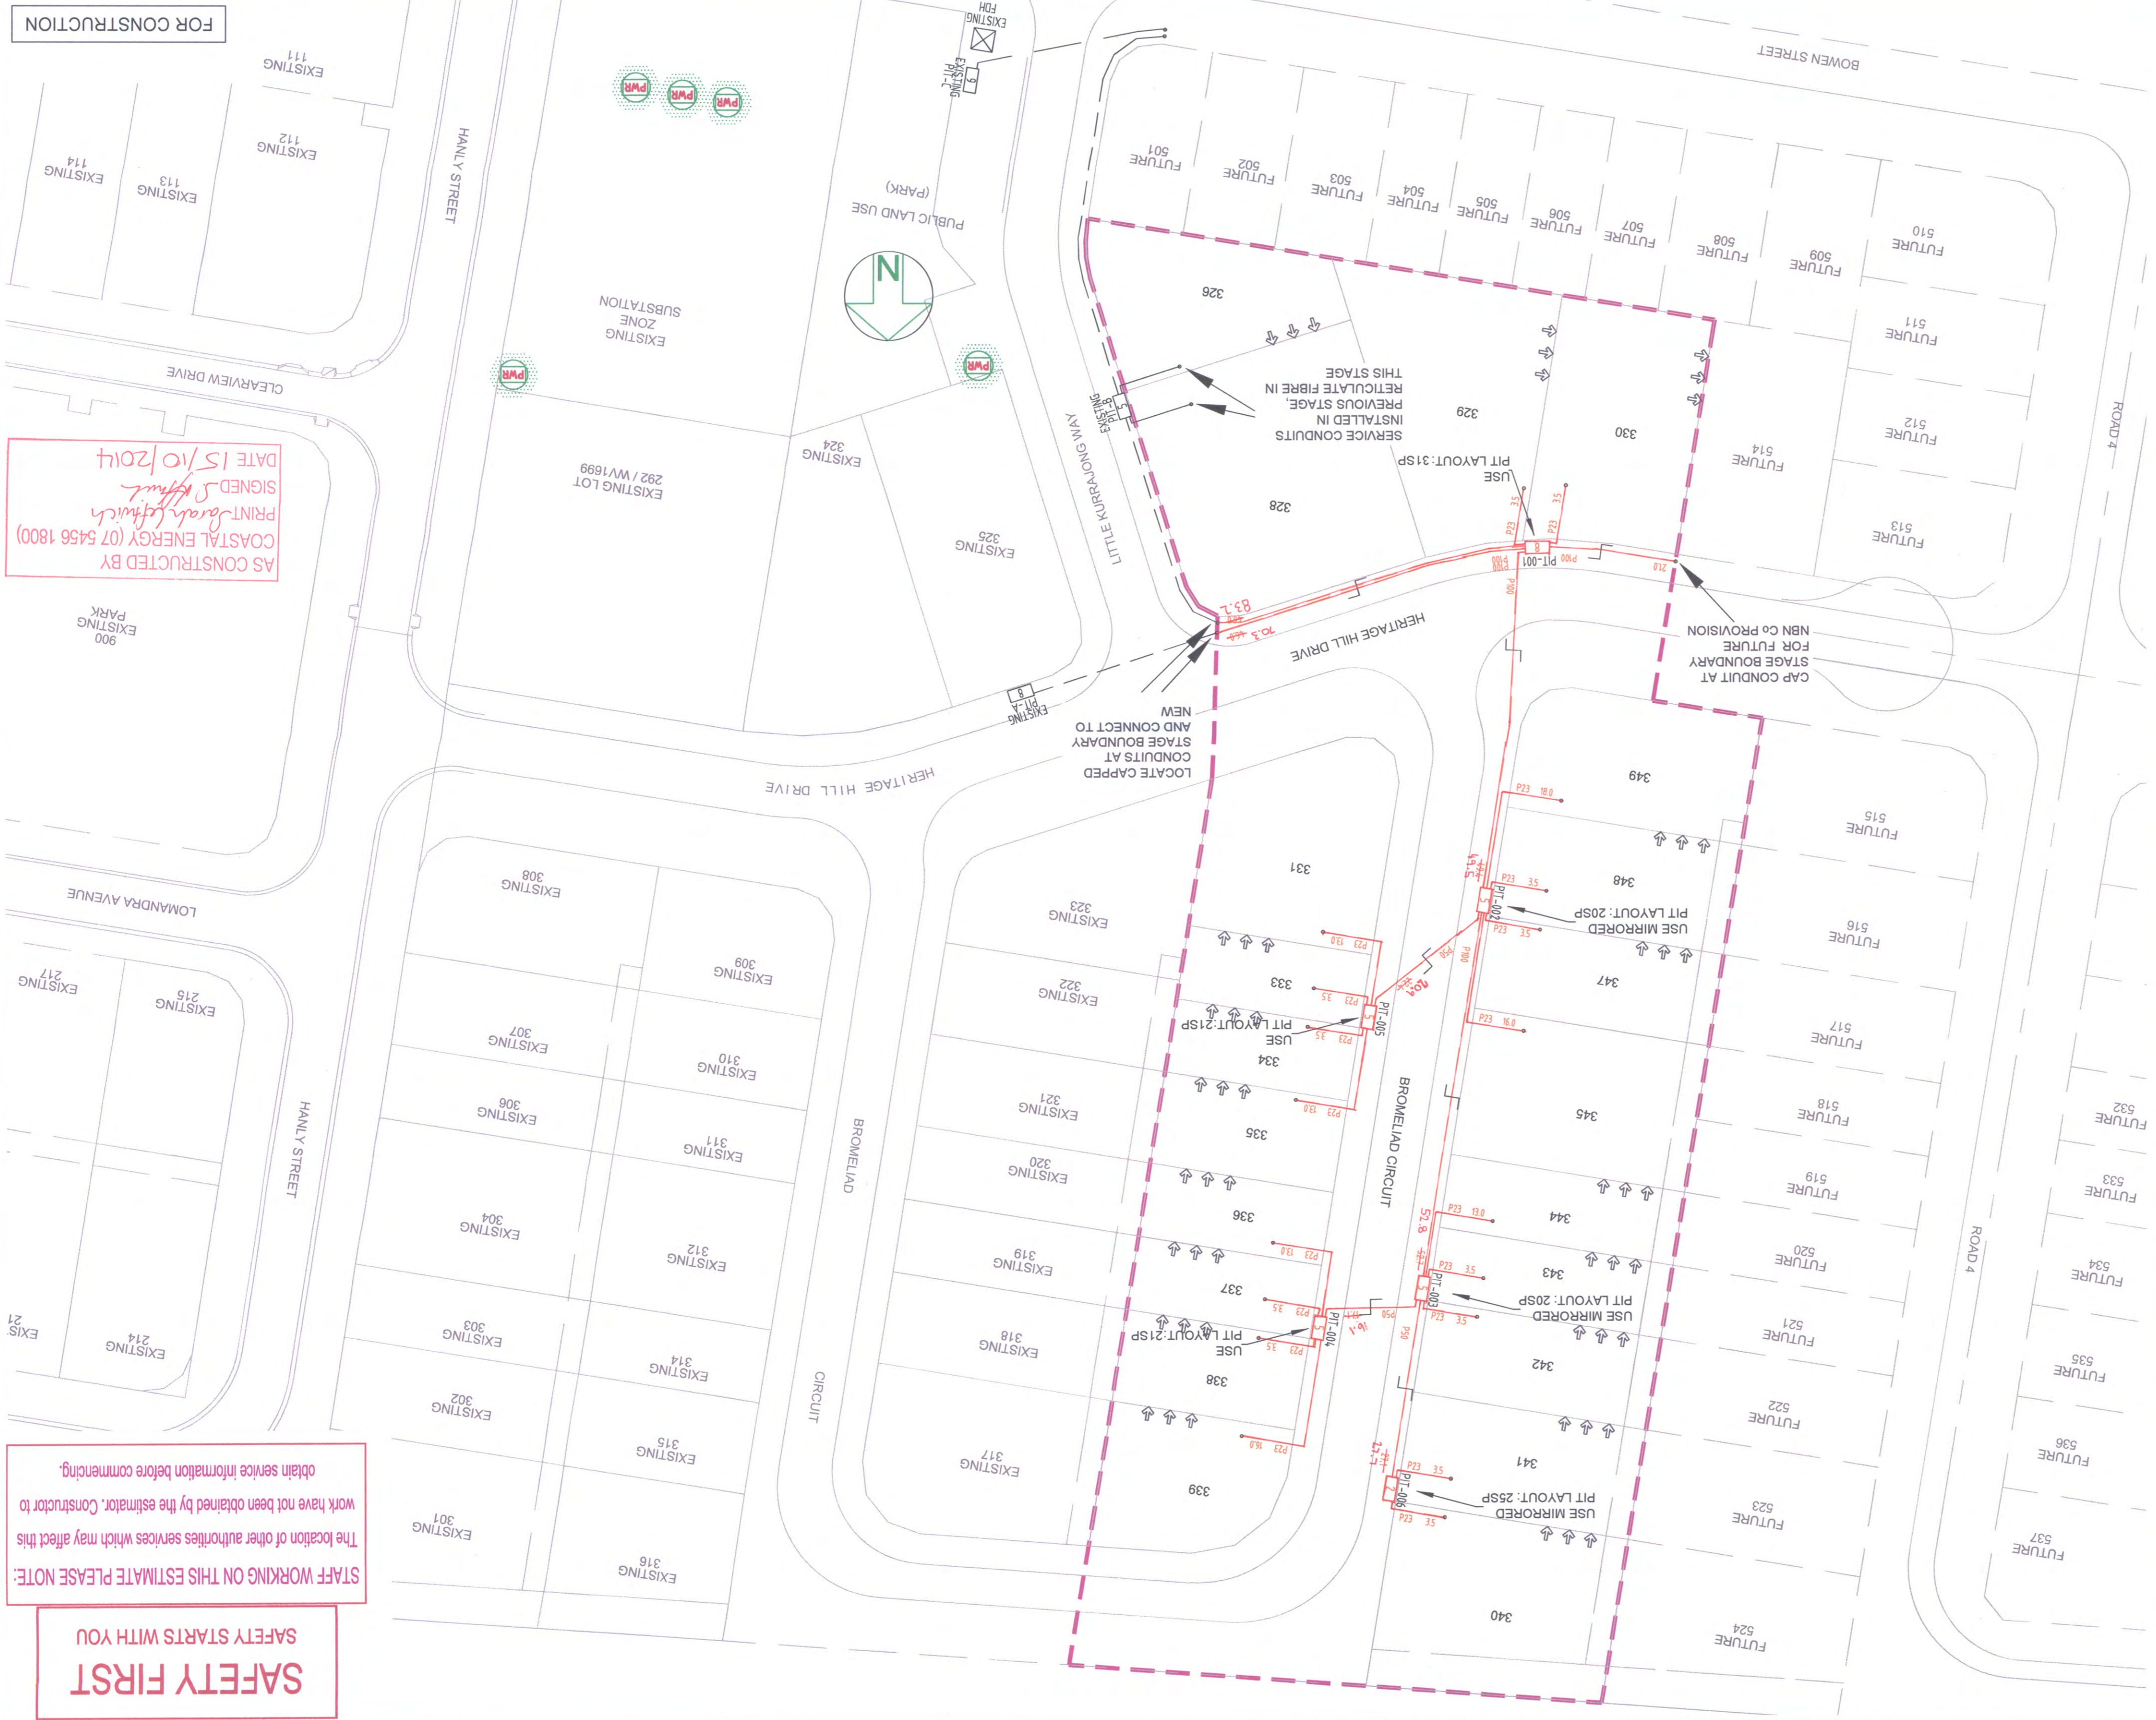

SAFETY FIRST
SAFETY STARTS WITH YOU
STAFF WORKING ON THIS ESTIMATE PLEASE NOTE:
The location of other authorities services which may affect this work have not been obtained by the estimator. Constructor to obtain service information before commencing.

CONDUIT CONFIGURATION

CONDUITS AND DUCTS ARE IN LAYER:
< 1460 NBN Support - Underground >
AND TERMINOLOGY CATEGORISED INTO TWO GROUPS IN THE DRAWINGS AS PER BELOW:
1- DUCT
2- CONDUIT
USED WITH LOCAL NETWORK
USED WITH LEAD-IN DROPS
ATTRIBUTES ATTACHED TO CONDUITS ARE AS SHOWN

CONDUIT ID
CONDUIT SIZE
CONDUIT LENGTH

NOTE:
- P100 HAS AN INTERNAL DIAMETER OF 104.9 mm AND A MINIMUM WALL THICKNESS OF 4.5 mm
- P20 HAS AN INTERNAL DIAMETER OF 53 mm AND A MINIMUM WALL THICKNESS OF 3.1 mm
- P50 HAS AN INTERNAL DIAMETER OF 23.3 mm AND A MINIMUM WALL THICKNESS OF 1.4 mm

LEGEND

[Symbol]	TRANSFORMER / KIOSK / PAD MOUNT SUB-STATION / POLE MOUNT TRANSFORMER
[Symbol]	FIBRE DISTRIBUTION HUB
[Symbol]	ZERO LOT PROPERTY BOUNDARY
[Symbol]	FDH CABINET
[Symbol]	ACO CABLEMATE TYPE 2
[Symbol]	PLASTIC PIT OR SIMILAR
[Symbol]	END CAP CONDUIT WITH STATION NO.
[Symbol]	ACO CABLEMATE TYPE 5
[Symbol]	P20+P22 mm NBNC SERVICE CONDUIT
[Symbol]	ACO CABLEMATE TYPE 8
[Symbol]	PLASTIC PIT OR SIMILAR LOCAL CONDUIT (P100/P50)
[Symbol]	EXISTING CONDUIT
[Symbol]	ACO CABLEMATE TYPE 9
[Symbol]	PLASTIC PIT OR SIMILAR
[Symbol]	NBNC STAGE BOUNDARY
[Symbol]	EXISTING NBNC PIT

NOTE:
1. PITS TO BE LOCATED CLEAR OF THE ERGON PILLAR EXCLUSION ZONE.
2. REFER TO NBN CO DOCUMENT NO. NBN-TE-CO-194 (DEPLOYMENT OF THE NBN CO CONDUIT AND PIT NETWORK - GUIDELINES FOR DEVELOPERS) FOR DETAILED SPECIFICATION.
3. PITS TO INCLUDE LID GASKET TO PREVENT DIRT ENTRY AND SPREADER BARS TO PREVENT PIT BUCKLING DURING BACKFILL / GROUND COMPACTION. PITS TO BE EMBOSSED WITH NBN AND COMPLY AS PER CLAUSE 5.32 OF THE ABOVE NBN CO DOCUMENT.
4. SERVICE CONDUITS TO EXTEND 1m INSIDE THE FRONT PROPERTY BOUNDARY. FOR DISTANCES FROM SIDE PROPERTY BOUNDARY, REFER APPLICABLE PIT LAYOUT DETAILS OR SERVICE CONDUIT DETAIL FOR BOUNDARIES WITHOUT NBN PIT CONTRACTORS TO TELECOMMUNICATIONS CAUTION TAPE TO END OF SERVICE CONDUITS AND EXTEND TO ABOVE GROUND LEVEL FOR FUTURE CONDUIT LOCATION.
5. ALL CONDUITS TO ENTER AND EXIT AT NARROW ENDS OF PITS ONLY. LOCATE CONDUITS AS CENTRALLY IN PIT END WALLS AS POSSIBLE. CONDUITS SHALL NOT BE INSTALLED WITHIN 50 mm OF ANY CORNER OF THE PIT. MINIMUM SEPARATION BETWEEN CONDUITS TO BE 25 mm. INSTALL CONDUITS AND CONDUIT COLLARS (BUSHES) TO BE SQUARE AND FLUSH WITH THE PIT END WALL. REFER TO THE PIT END WALL DETAILS IN THIS DESIGN FOR ADDITIONAL REQUIREMENTS.
6. MINIMUM COVER TO BE 300 mm FOR SERVICE DROP CONDUITS, 450 mm IN VERGE, 600 mm UNDER LOCAL ROADS, AND 800 mm UNDER MAIN ROADS.
7. CONDUITS ARE TO BE CLEANED AND PROVEN USING A MANDREL. AFTER TESTING INSTALL A SUITABLE DRAW ROPE TO ALL CONDUITS AND CAP CONDUIT ENDS. SEAL CONDUITS AT PITS TO PREVENT ENTRY OF DUST AND MOISTURE. SERVICE CONDUIT DRAW ROPES TO BE ADDITIONALLY FITTED WITH A PLASTIC LABEL AT PIT END, IDENTIFYING LOT NUMBER AND DISTANCE / DIRECTION FROM BOUNDARY.
8. INSTALL NON CONDUCTIVE (METAL FREE) MARKER TAPE ABOVE ALL NBN CO CONDUITS, 300 mm BELOW FINISHED GROUND LEVEL. INSTALL METALLIC KERB MARKERS AT ROAD CROSSINGS.
9. REFER TO ERGON ENERGY STANDARD DRAWINGS 5228 AND 5168 SHEETS 1 TO 3 FOR SHARED TRENCH CROSS SECTIONS.
10. GRADE TOP OF PIT TO MATCH VERGE / FOOTPATH.
11. THERE ARE A TOTAL OF 21 RESIDENTIAL DWELLINGS OVER 21 LOTS. MADE UP OF 21 SINGLE DWELLING LOTS.
12. ALL OF THE STAGE IS TO BE FED FROM EXISTING FDH INSTALLED IN STAGE 1A. REFER TO NBN CO PROJECT NO. AYCA-E0089 FOR DETAILS.
13. WHERE REQUIRED, SUPPLY AND INSTALL SERVICE AND ROAD CROSSING CONDUITS SHOWN IN THE PIT LAYOUTS.
14. SUPPLY AND INSTALL ADDITIONAL DEVIATING CONDUIT BENDS TO ACHIEVE THE INCREASED / DECREASED BURIAL DEPTH REQUIRED TO AVOID CLASH WITH OTHER SERVICES.