IMPORTANT NOTE

1. This plan was prepared for the sole purposes of the client for the specific purpose of recording the infrastructure for Central Highlands / Isaac Regional Council. This plan is strictly limited to the Purpose and does not apply directly or indirectly and will not be used for any other application, purpose, use or matter. The plan is presented without the assumption of a duty of care to any other person (other than the Client) ("Third Party") and may not be relied on by Third Party.

2. RPS Australia East Pty Ltd will not be liable (in negligence or otherwise) for any direct or indirect loss, damage, liability or claim arising out of or incidental to:
   a. a Third Party publishing, using or relying on the plan;
   b. RPS Australia East Pty Ltd relying on information provided to it by the Client or a Third Party where the information is incorrect, incomplete,
   c. inaccurate, out-of-date or unreasonable;
   d. any inaccuracies or other faults with information or data sourced from a Third Party;
   e. RPS Australia East Pty Ltd relying on surface indicators that are incorrect or inaccurate;
   f. the Client or any Third Party not verifying information in this plan where recommended by RPS Australia East Pty Ltd;
   g. lodgment of this plan with any local authority against the recommendation of RPS Australia East Pty Ltd;
   h. the accuracy, reliability, suitability or completeness of any approximations or estimates made or referred to by RPS Australia East Pty Ltd in this plan.

3. Without limiting paragraph 1 or 2 above, this plan may not be copied, distributed, or reproduced by any process unless this note is clearly displayed on the plan.

4. Scale shown is correct for the original plan and any copies of this plan should be verified by checking against the bar scale.

5. Type and size of mains, locations and levels of house connection branches and ends have been provided by the constructing contractor and have not been verified. Other information has been obtained from design and construction information [provided by Third Parties] and should be checked before use.

CERTIFICATION

RPS Australia East Pty Ltd (ACN 055 931 096) Registered Surveyor, certifies that the locations, surface and invert levels of the sewerage infrastructure on this plan have been surveyed in accordance with the requirements of the [insert] and, to the best of our knowledge and subject to the Important Note below, are accurate.

RDG ..... Authorised Signatory

4/11/13 ..... Date

LEGEND

- 150ø uPVC PIPES
- MANHOLE
- HOUSE CONNECTION
- EXISTING SEWER LINE

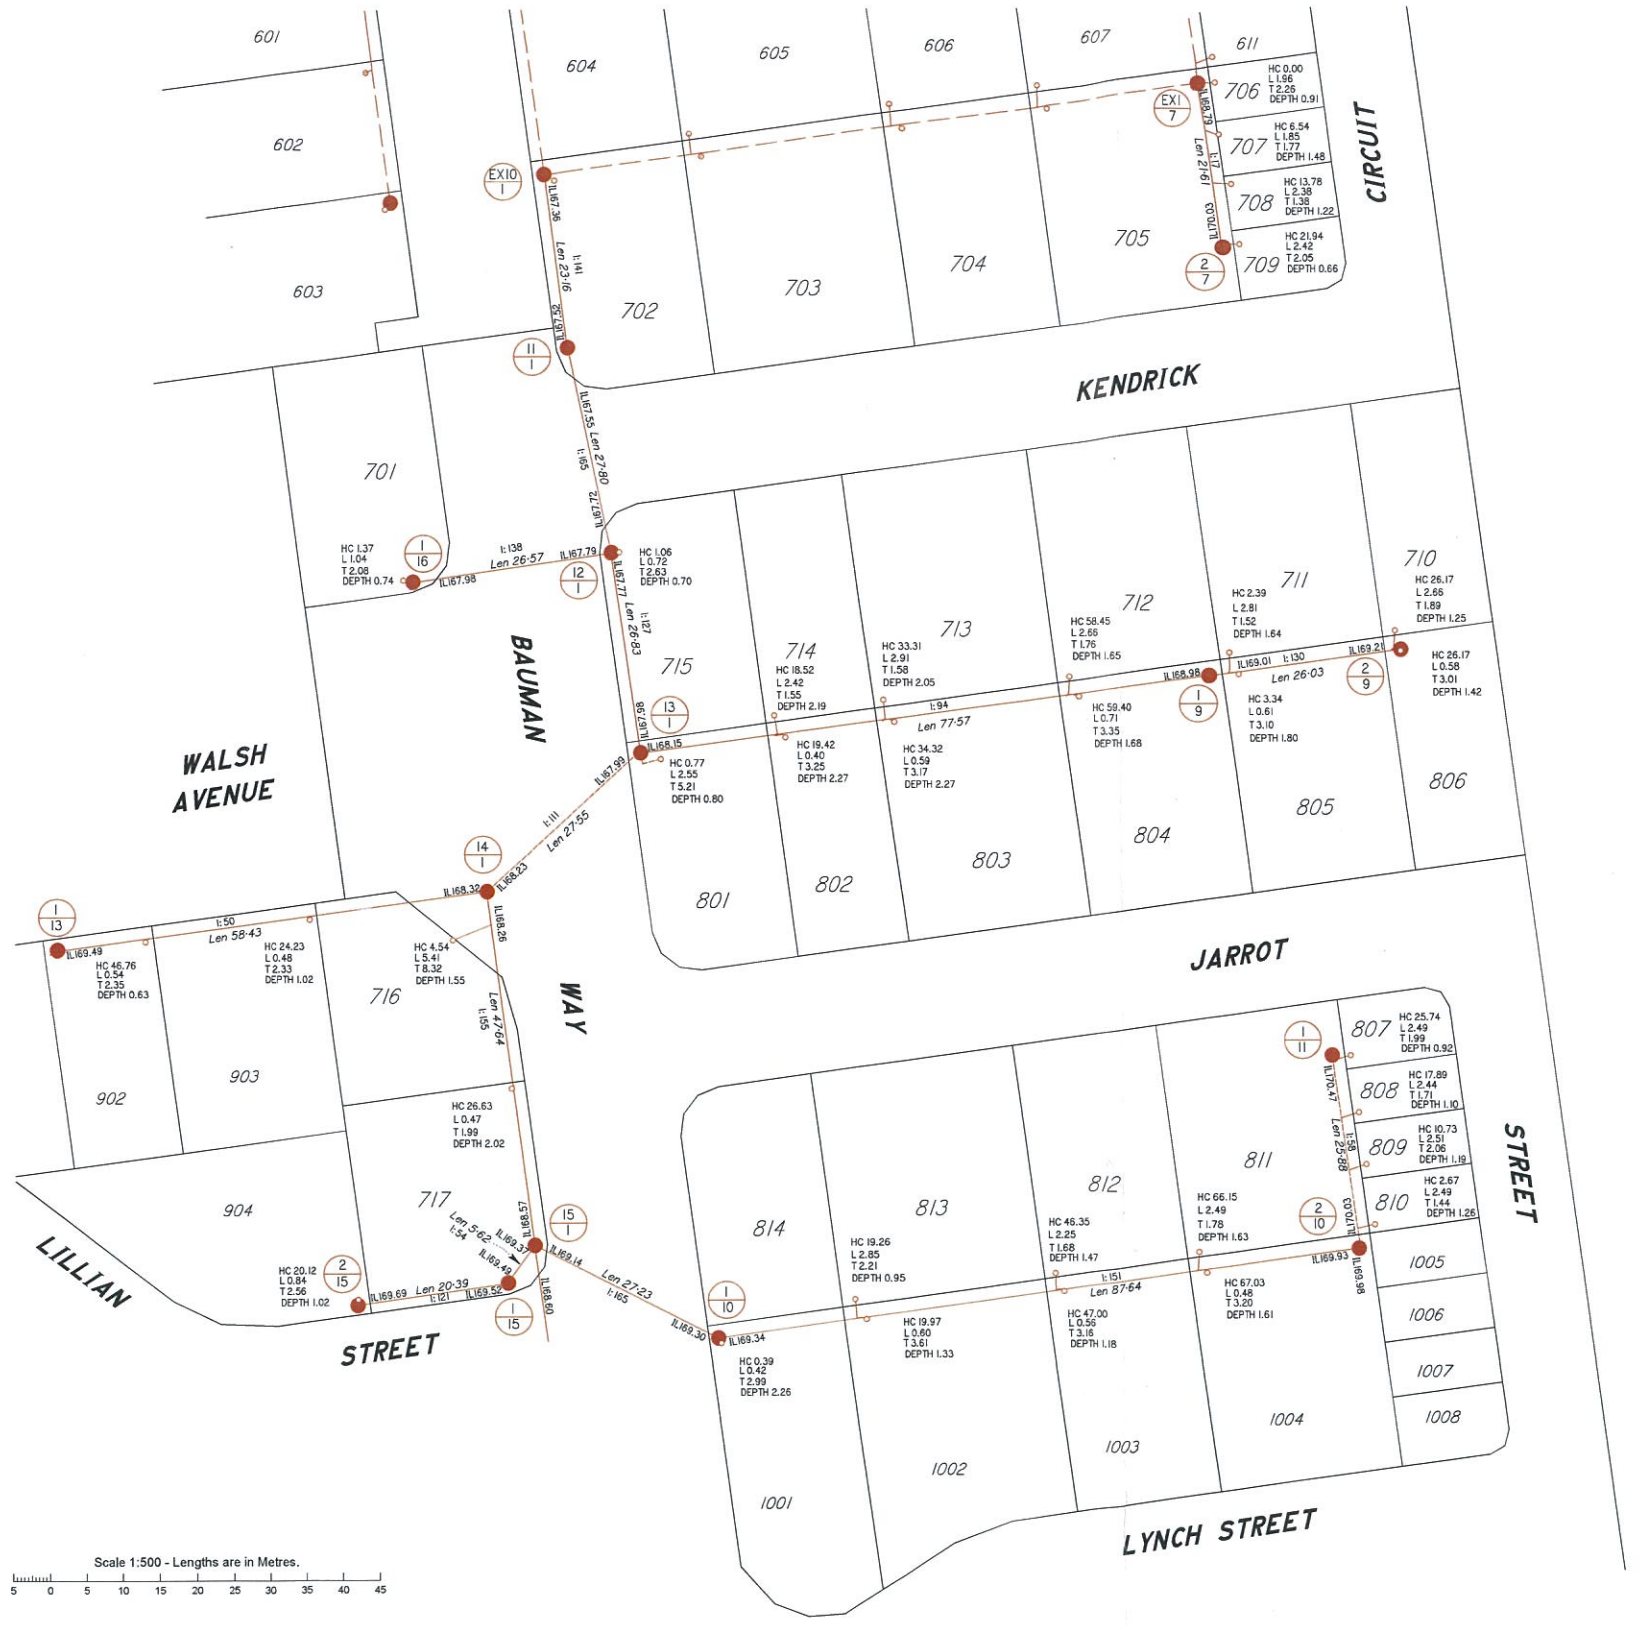

Rev.	Revisions	Date	Approved
A	ORIGINAL ISSUE	21/05/2013	RDG

	Init	Date
Surveyed	RPS	Feb 2013
Designed		
Drawn	RLE	20/05/2013
Checked	RDG	01/11/2013

Horiz. Datum: PLANE vide IS232597
Level Datum: AHD Der PM35585, RL 185.914
Contour Int:
CCAD: 113912_Plane_Ascon
Parish: Blackwater
County: Humboldt
Locality: Blackwater
Local Authority: Central Highlands Regional Council

Client: JK CIVIL

Project: BLUE RIDGE ESTATE

Title: SEWER ASCONTRUCTED
STAGES 7 & 8
BAUMAN WAY, BLACKWATER
SHEET 1 OF 1

Scale: 1:500 @ A1
Date: 01/11/2013
WO No.: 113912-1

RPS
RPS Australia East Pty Ltd
ACN 140 292 762
ABN 44 140 292 762
©COPYRIGHT PROTECTS THIS PLAN
Unauthorised reproduction or amendment not permitted. Please contact the author.
1/112 Egerton Street
PO Box 655
Emerald QLD 4720
T +61 7 4982 1631
F +61 7 4982 1941
W rpsgroup.com.au

Drawing No.: 113912-ASCON-SEWER-03
Rev.: A