



IMPORTANT NOTE

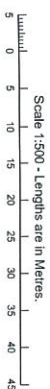
1. This plan was prepared for the specific purposes of the client for the specific purpose of recording the information and the information was not obtained from any other person (other than the client) and this plan is presented without the assumption of a duty of care to any other person (other than the client). This plan may or may not be relied on by a Third Party.
2. RPS Australia East Pty Ltd will not be taken in negligence or otherwise for any direct or indirect loss, damage or injury caused by the use of this plan by:
 - a. a Third Party publishing, using or relying on the plan;
 - b. RPS Australia East Pty Ltd relying on information provided to it by the client or a Third Party where the information is not reasonably relied on;
 - c. information supplied or received by a Third Party;
 - d. any inaccuracies or other faults with information or data sourced from a Third Party;
 - e. RPS Australia East Pty Ltd relying on information that is sourced in accordance with the plan.
3. The Client or any Third Party not verifying information in this plan were recommended by RPS Australia East Pty Ltd that they verify information against the recommendation of RPS Australia East Pty Ltd.
4. Judgment of this plan with any local authority against the recommendation of RPS Australia East Pty Ltd.
5. The accuracy, reliability, suitability or completeness of any approximations or estimates made or referred to by RPS Australia East Pty Ltd in this plan.
6. Without limiting paragraph 1, or if above, the plan may not be copied, distributed or reproduced by any person other than the client. The plan may not be used to create a new plan.
7. This process creates this plan as a clearly displayed set of the plan.
8. Scale shown is correct for the original plan and any copies of this plan should be verified by checking against the scale.
9. Type and date of each location and block of land is shown according to zoning and each area shown is highlighted in a different colour. The plan is not intended to show the boundaries of any lot or lots. Any information has been obtained from the relevant authority and is not intended to be relied on for any purpose other than for the purposes of planning and construction information provided by this Parties and should be checked before use.

CERTIFICATION

RPS Australia East Pty Ltd (ACN 005 931 096) Registered Surveyor, certifies that the locations, surface and invert levels of the sewerage infrastructure on this plan have been surveyed in accordance with the requirements of the [insert] and, to the best of our knowledge and subject to the Important Note below, are accurate.

Authorised Signatory

Date 1/11/15

[illegible]